


# T. 33 S., R. 1 W., W. M.

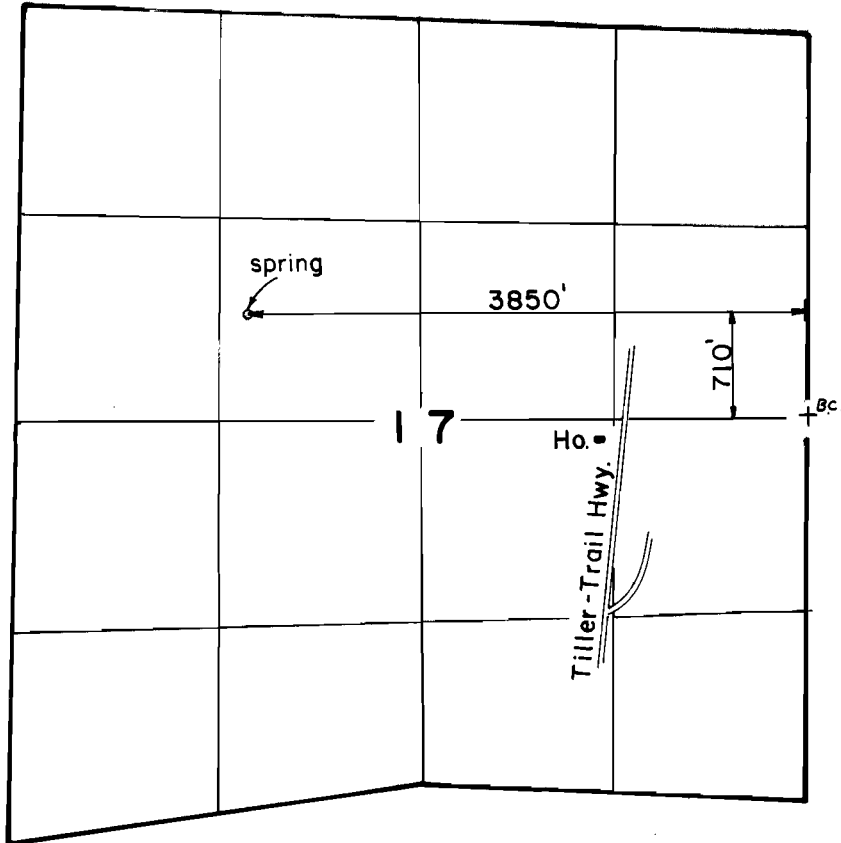

Scale: 1" = 1320'

## FINAL PROOF SURVEY UNDER

Application No. 62153 Permit No. 46380  
IN NAME OF

ROBERT DEAN PECK

Surveyed MAY. 17. 1990, by B. S. JAMES.