
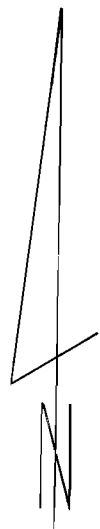
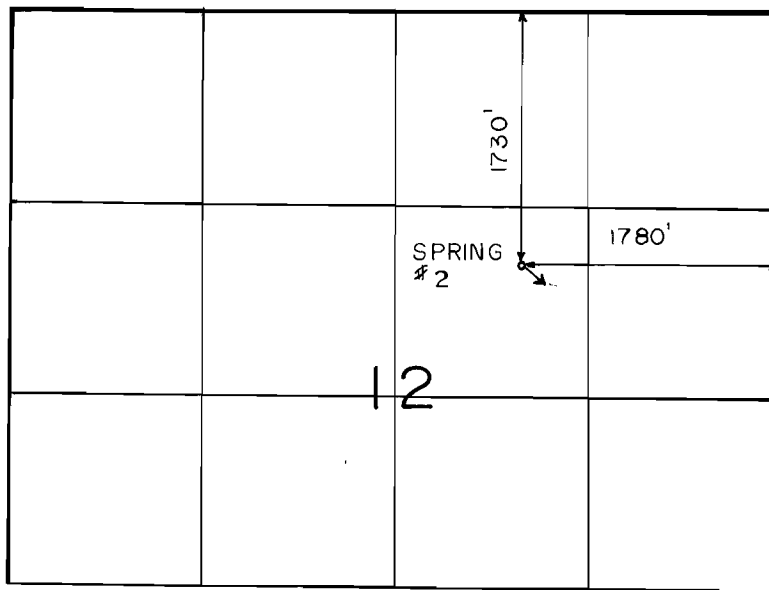


T. 8 S., R. 18 E., W.M.

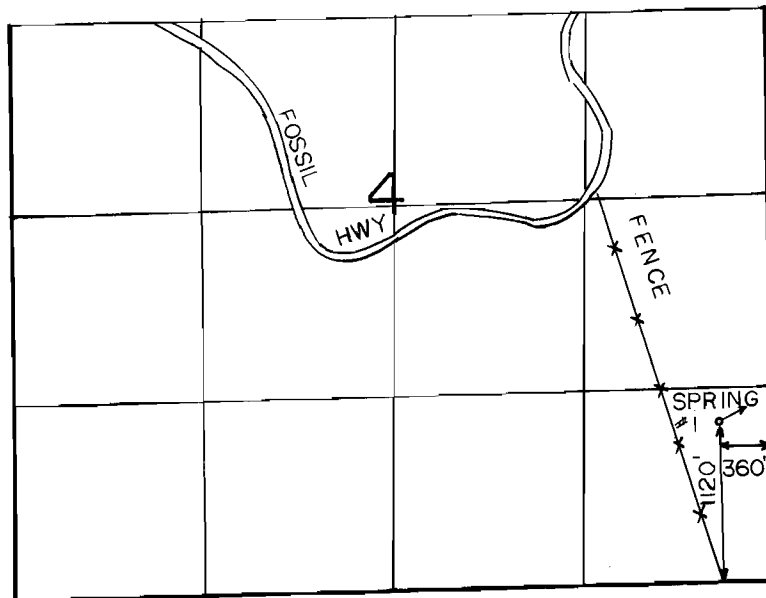

1" = 1320'

### FINAL PROOF SURVEY UNDER

Application No. 63331 Permit No. 46719

IN NAME OF

MAURER

Surveyed AUG. 14 1990, by B BISHOP

5-6-91 DSM  
41065-279-161R  
41065-279-162L