


48506
66594

T. 40 S., R. 19 E., W.M.

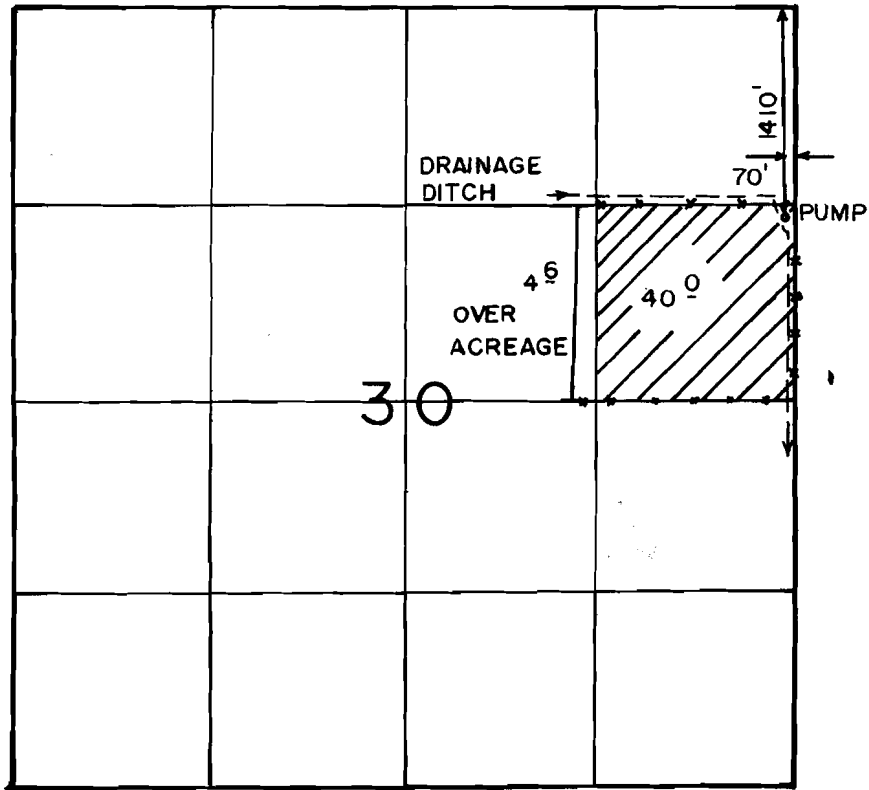

1" = 1320'

FINAL PROOF SURVEY
UNDER

Application No. 66599 Permit No. 48506
IN NAME OF Cert. #66594

GEORGE OTIS MOBLEY

Surveyed 8-22 1990, by BW BISHOP

PTS II-1990
5-3-91 DSM