


T. 34 S., R. 1 W., W. M.

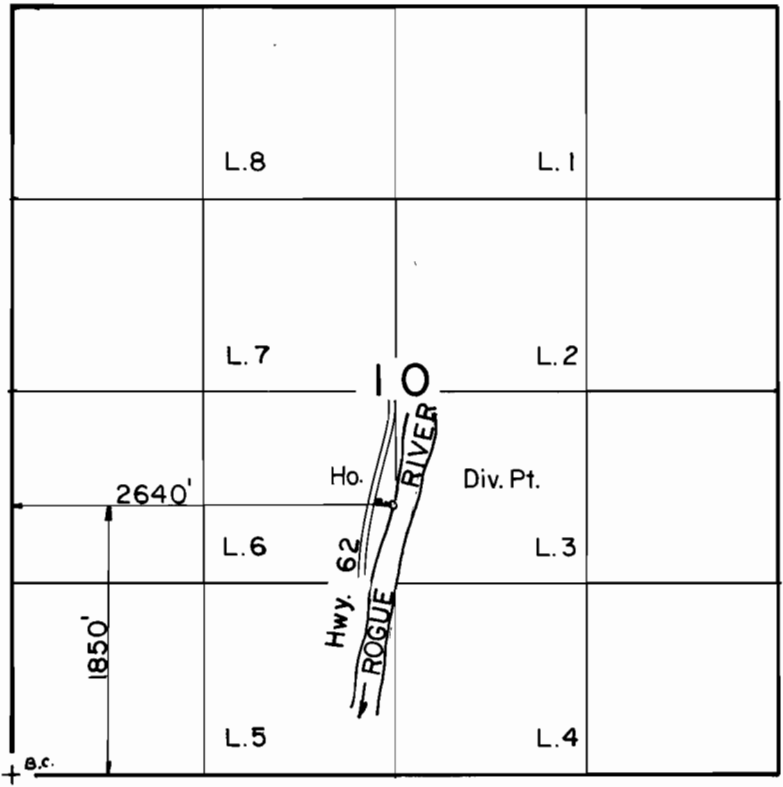

Scale: 1" = 1320'

FINAL PROOF SURVEY UNDER

Application No. 68314... Permit No. 49280...
IN NAME OF

JAMES U. & JEANETTE C. AYER

Surveyed MAR. 20, 1990, by B. S. JAMES