


T. 33 S., R. 2 E., W. M.

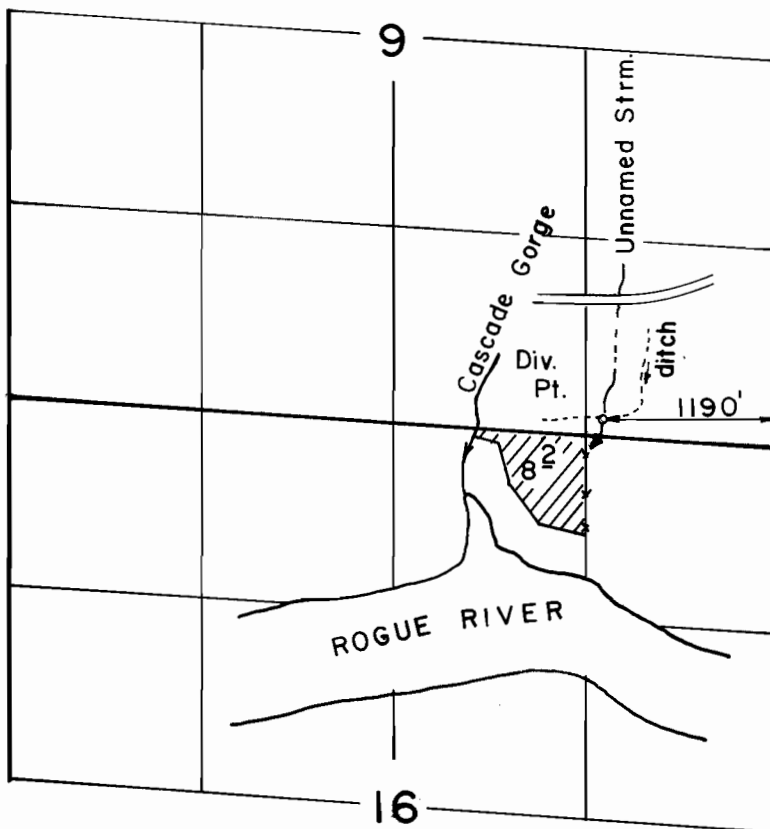

Scale: 1" = 1320'

FINAL PROOF SURVEY
UNDER

Application No. 68327.. Permit No. 49343....
IN NAME OF

..... **JAMES HOLT**

Surveyed JULY...6... 19.20, by B....S....JAMES....