


T. 33 S., R. 1 W., W. M.

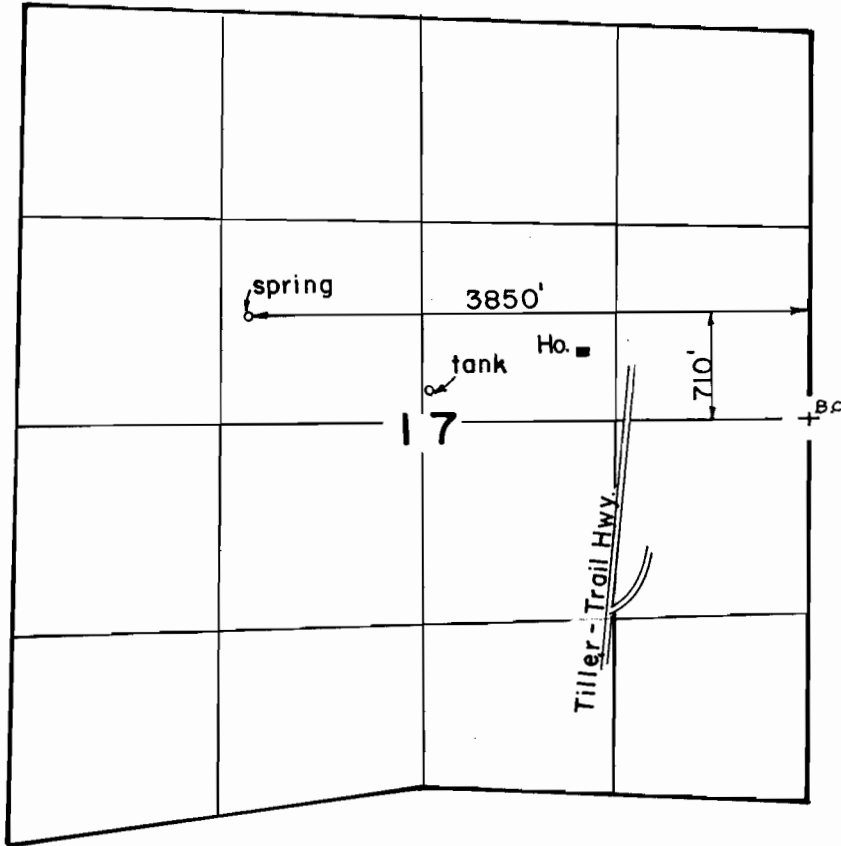

Scale: 1" = 1320'

FINAL PROOF SURVEY UNDER

Application No. 68828. Permit No. 49865
IN NAME OF

RAYMOND W. & JUDITH A. CAYFORD

Surveyed M.A.Y. 17. 1990, by B. S. JAMES.