


# T. 36 S., R. 5 W., W. M.

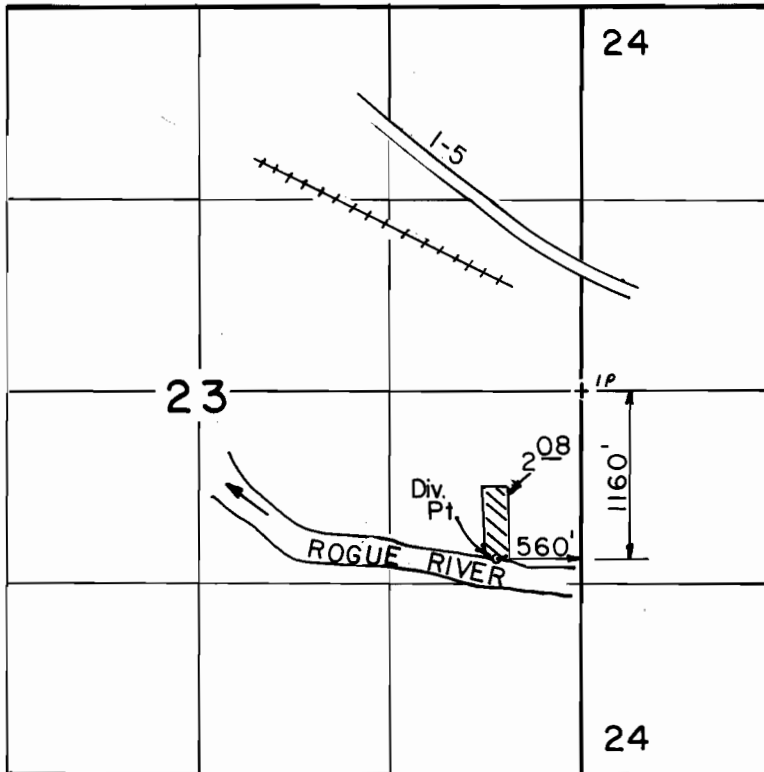

Scale: 1" = 1320'

## FINAL PROOF SURVEY UNDER

Application No. 68971 Permit No. 49970  
IN NAME OF

KARYL MORT & BEVERLY PETERSON

Surveyed OCT. 3, 1990, by L. M. JOACHIMS