
Sec.28, Twsp.19 S., R. 47 E., W.M.

N.W. Cor. Sec. 28

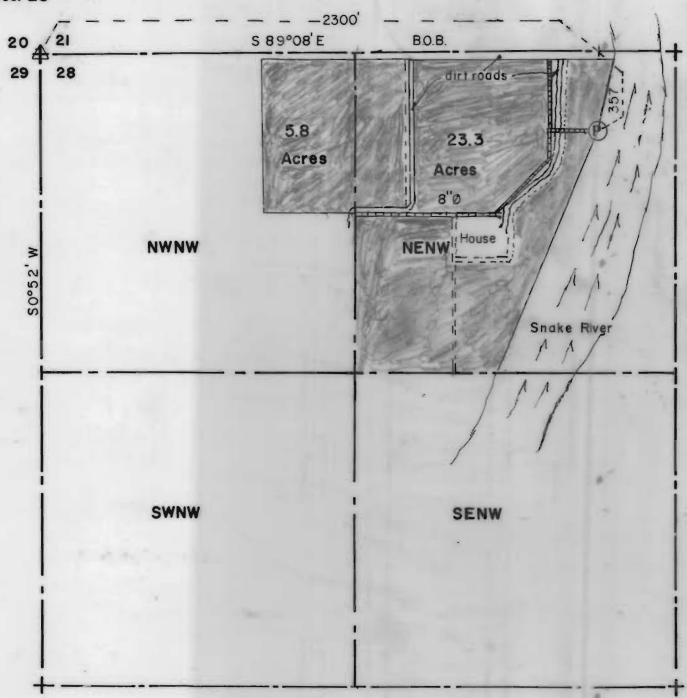

FINAL PROOF SURVEY


DISCLAIMER

I, ALBERT GASCHLER, HEREBY CERTIFY: THAT THIS MAP WAS MADE TO BE A PART OF THE APPLICATION FOR A FINAL PROOF SURVEY OF PERMIT No. 50369, SECTIO-NAL LINES SHOWN ARE APPROXIMATE AND THIS MAPIS NOT INTENDED FOR ANY OTHER USE AND DOES NOT GUARANTEE LAND OWNERSHIP.

LEGEND

U.S. GOVERNMENT CORNER EXISTING WATER RIGHT SUPPLEMENTAL WATER RIGHT

Permit No. 50369

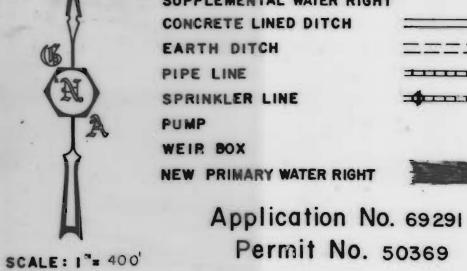

Certified Water Right Examine, 2052 Certified Water Right Examine, 2052 Albert Gaschler Nov. 19, 1967 FOR OREGON	EXISTING PERMITS:
Control of the last of the las	EXAMINERS MAP

FOR: LI	ANE M	LARSEN		
GAS	CHLE	R&AS	SSOC	OREGON
CHECKED BY:				distribution of the second

■ 0-2 PG 20 DRAWING NO. A-459 DATE: 8/18/89

SHEET 2 OF 3 JOS NO. WO-0789

REVISED: