

# SEC. 32, T.3S, R.1E, W.M.

SECTION 31  
SECTION 32

FD. STONE IN  
MON. BOX AT  
WEST 1/4 COR.

3275'

(REALIGNED)

INTAKE

MOLALLA RIVER

KNIGHTS BRIDGE RD.


TL. 600

0.6 Ac.

S.W. 1/4  
N.E. 1/4

302'

N

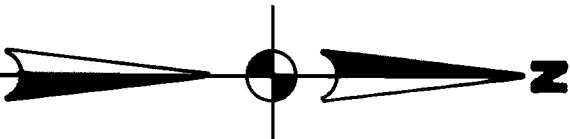

SCALE - 1" = 400'

## FINAL PROOF SURVEY

UNDER


APPLICATION NO. 69533, PERMIT NO. 50192

IN NAME OF

**JOHN MITSCH**

### NOTE:

THIS MAP IS FOR THE PURPOSE OF IDENTIFYING THE LOCATION OF THE WATER RIGHT ONLY AND HAS NO INTENT TO PROVIDE DIMENSIONS OR LOCATION OF PROPERTY OWNERSHIP LINES.

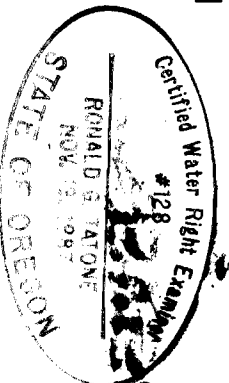

**ZAROSINSKI - TATONE  
ENGINEERS, INC.**

3737 S.E. 5TH AVENUE, PORTLAND, OREGON 97202

PHONE: (503) 238-0795

REVISED 4-17-91 R.R.