


T. 6S., R. 5W., W.M.

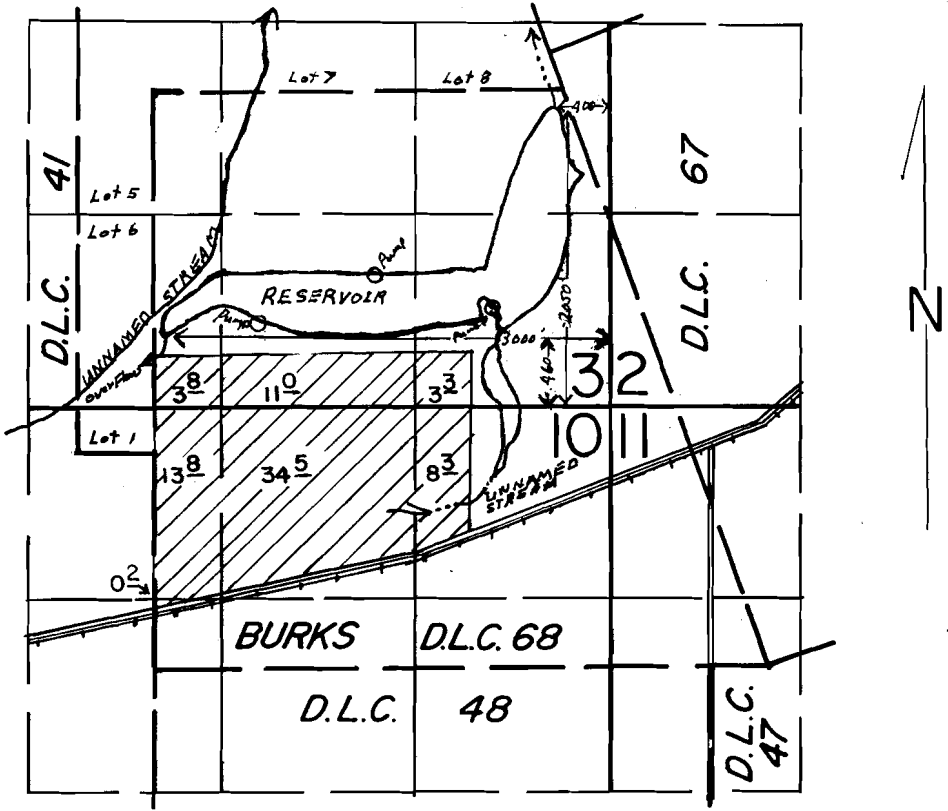

SCALE: 1"=1320'

FINAL PROOF SURVEY
UNDER

R-52346 R-6416
Application No. 52347... Permit No. 40288....
IN NAME OF

.....LILLIE WALKER.....

Surveyed APRIL 28, 1987..., by B.W. BISHOP.....