


T. 6S., R. 5W., W.M.

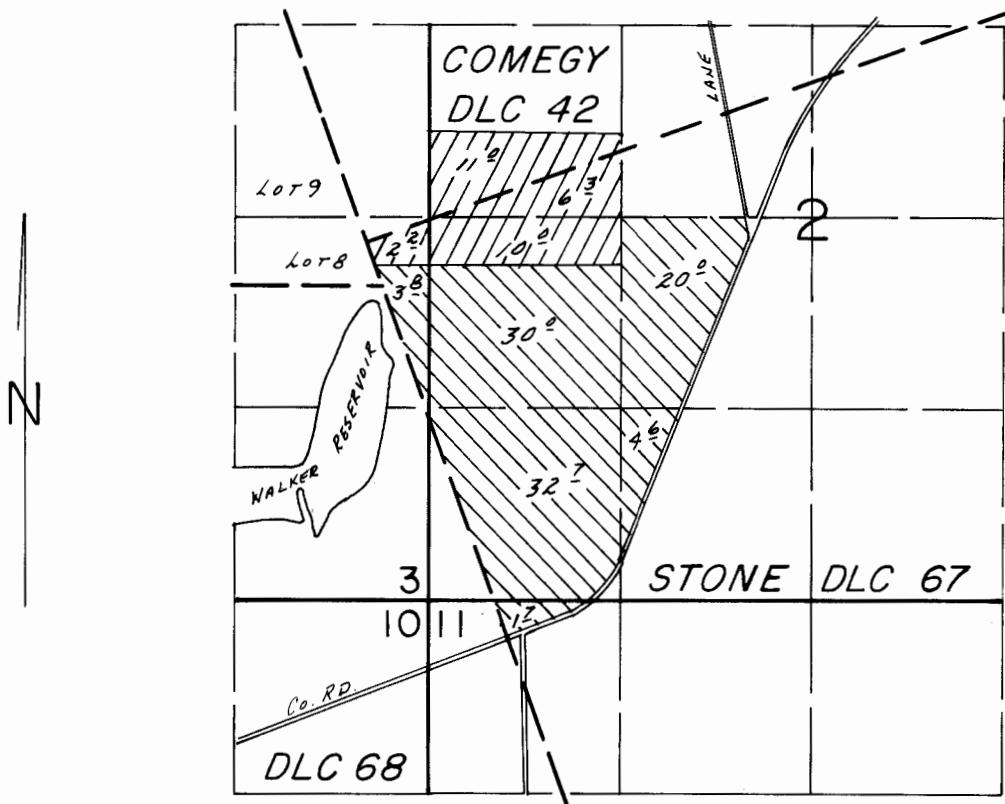


SCALE: 1" = 1320'

FINAL PROOF SURVEY UNDER

Transfer No. 3624



Transfer No. 3625

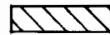

PORTION ONLY

IN NAME OF

R. L. WALKER FARMS, INC.

Surveyed Sept. 25, 1987, by B.W. BISHOP

3/13/89

41053-178-213A

BWB