


# T. 5 S., R. 1 E., W. M.

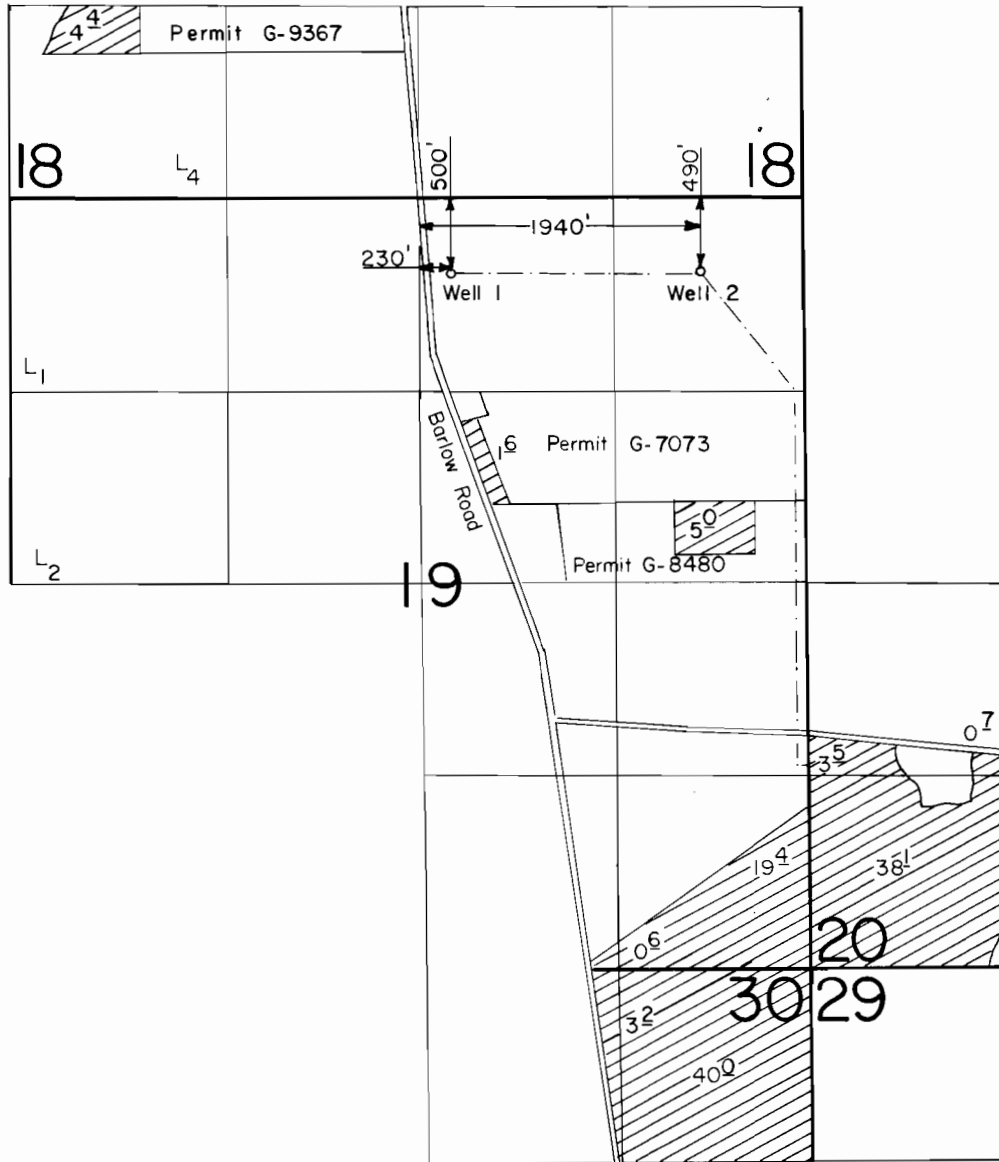

Scale : 1" = 1320'

## FINAL PROOF SURVEY UNDER

Application No. G-11342.. Permit No. G-10475..  
IN NAME OF

.....**HESSEL BIERMA**.....

Surveyed Nov. 3..... 1989., by T. Warren.....