


T. 8 S., R. 16 E., W.M.

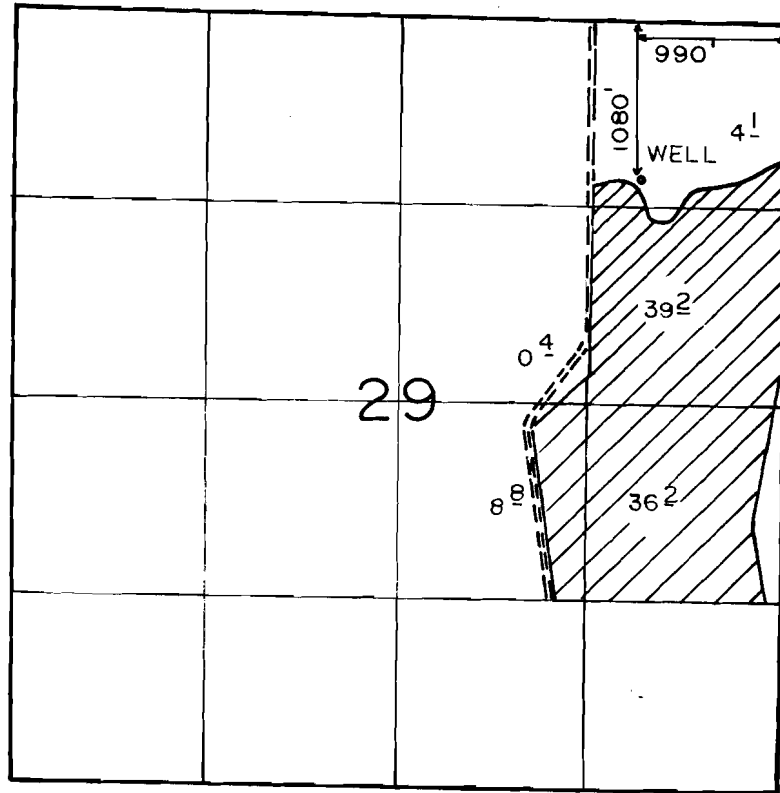

1" = 1320'

FINAL PROOF SURVEY
UNDER

Application No. G-7646 Permit No. G-7148
IN NAME OF

FARM CREDIT SERVICES

Surveyed AUG. 8. 1990., by B. BISHOP.....

5-7-91 DSM
41065-279-51R

G-7148