


T. 36 S., R. 11 E., W.M.

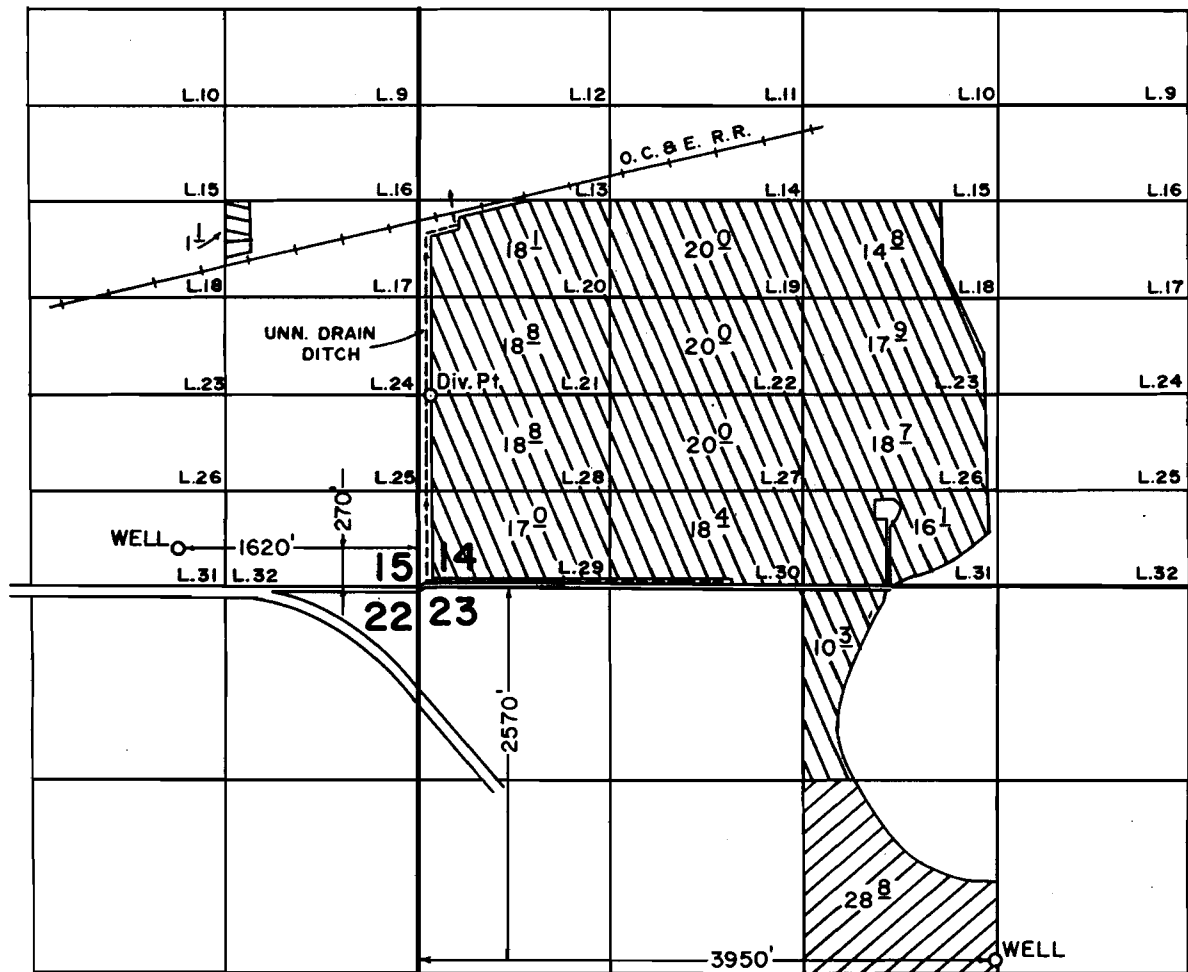

DIV. PT. LOC.: 1310' N. & 80' E. FROM THE SW CORNER OF SECTION 14.

SCALE: 1" = 1320'

FINAL PROOF SURVEY UNDER

63732

47038

G-9409

G-8781

Application No. G-8182. Permit No. [REDACTED] IN NAME OF

EDWIN K. & BONNIE B. VIEIRA

Surveyed SEPT. 27, 1989, by B. W. BISHOP

-  Supplemental
-  Primary
-  Primary