


T. 40 S., R. 14 W., W.M.

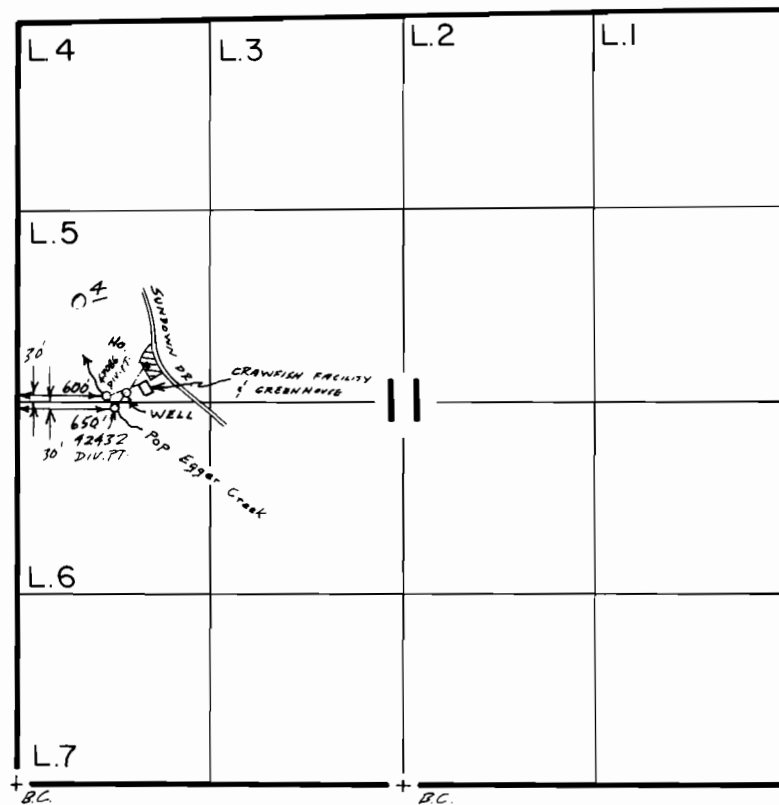

WELL 50' N 750' E from W 1/4 CORNER SECTION 11.

Scale: 1" = 1320'

FINAL PROOF SURVEY

UNDER

G-8529

G-7891

56559

42432

Application No. 63819 Permit No. 47086

IN NAME OF

GRAVENS

Surveyed May 19, 1987, by J.M. SCHMORDE