
90684

T. 40 S., R. 14 W., W.M.

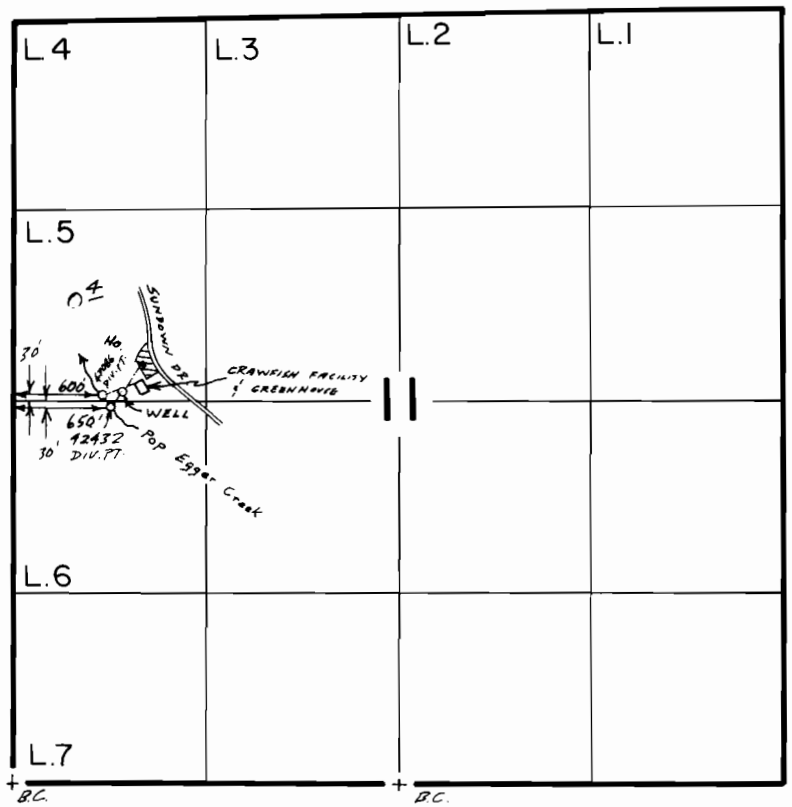

N

WELL: 50' N & 750' E from W¼ CORNER SECTION 11.

Scale: 1" = 1320'

FINAL PROOF SURVEY

UNDER

G-8529 G-7891
56559 42432

Application No. 63819 Permit No. 47086

IN NAME OF

CRAVENS

Surveyed May 19, 1987, by J.M. SCHMORDE

41015-180-1121 LmL

1/89