


T.14 S., R.13 E., W.M.

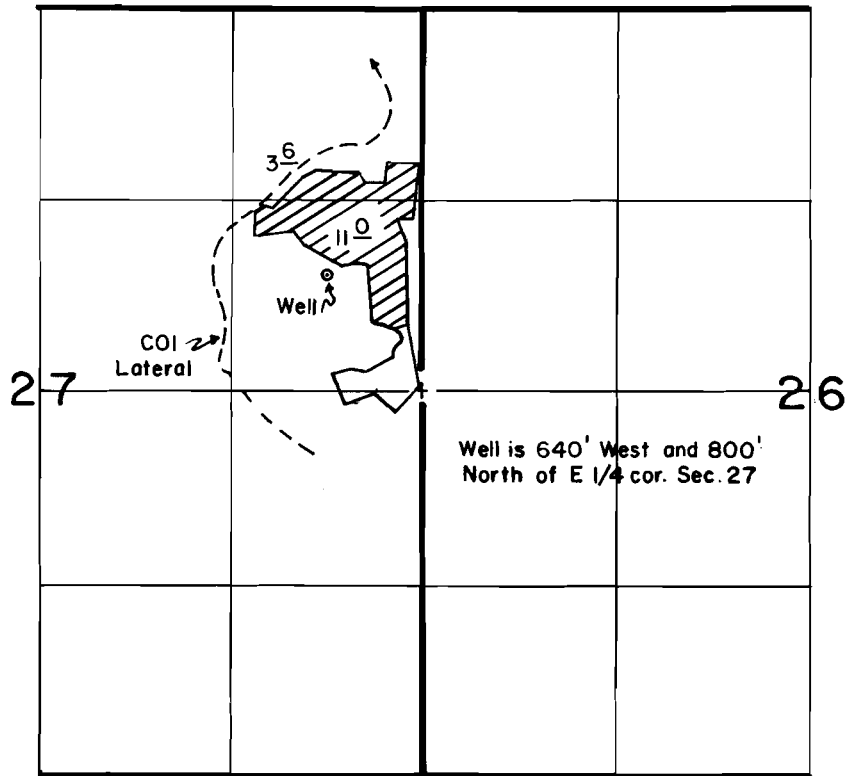

FINAL PROOF SURVEY
UNDER

Application No. G-9147 Permit No. G-8468.....
IN NAME OF

BURT L. JR., & VIRGINIA J. BURTON

Surveyed OCT. 10 1983, by D. PANTHER.....

Certificate 66626

Rec'd 10-15-91 WDA#11