


T. 37 & 38 S., R. 6 W., W.M.

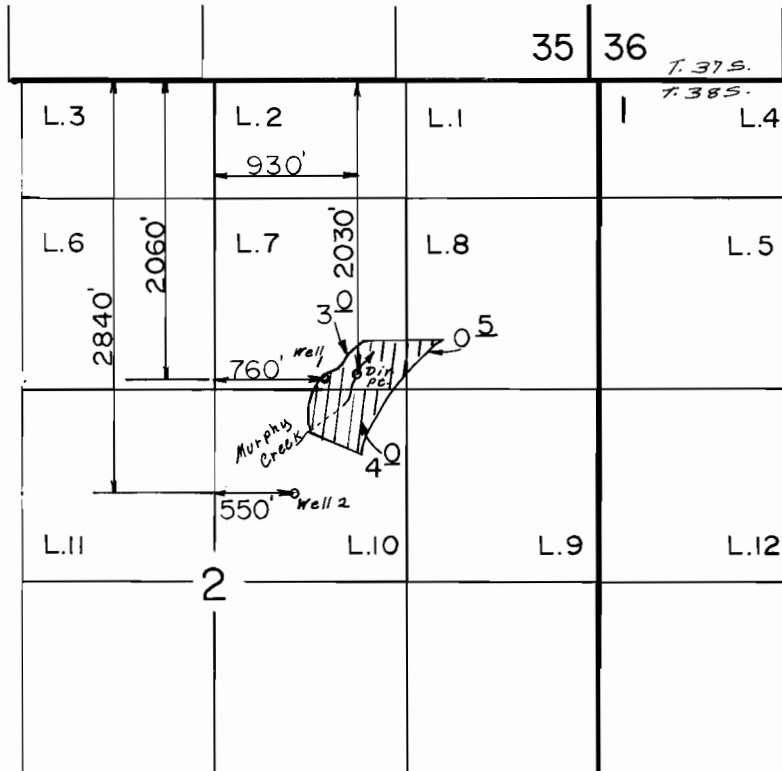

Scale: 1" = 1320'

FINAL PROOF SURVEY UNDER

G-10539 G-9694
 Application No. 53296 Permit No. 39546....
 IN NAME OF

WALTER I. & CONSTANCE BERG

Surveyed MAY 24... 1988, by B... S... JAMES....