


# T. 37 & 38 S., R. 6 W., W.M.

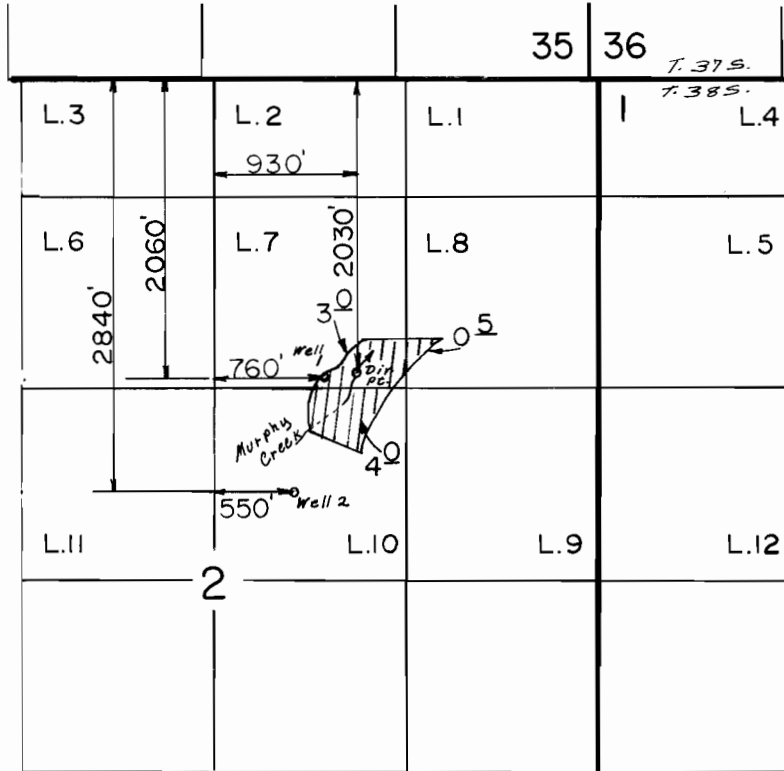

Scale: 1" = 1320'

## FINAL PROOF SURVEY UNDER

G-10539                      G-9694  
 Application No. 53296 Permit No. 39546....  
 IN NAME OF

### WALTER I. & CONSTANCE BERG

Surveyed MAY 24... 1988, by B. S. JAMES....