


# T. 8 S., R. 40 E., W.M.

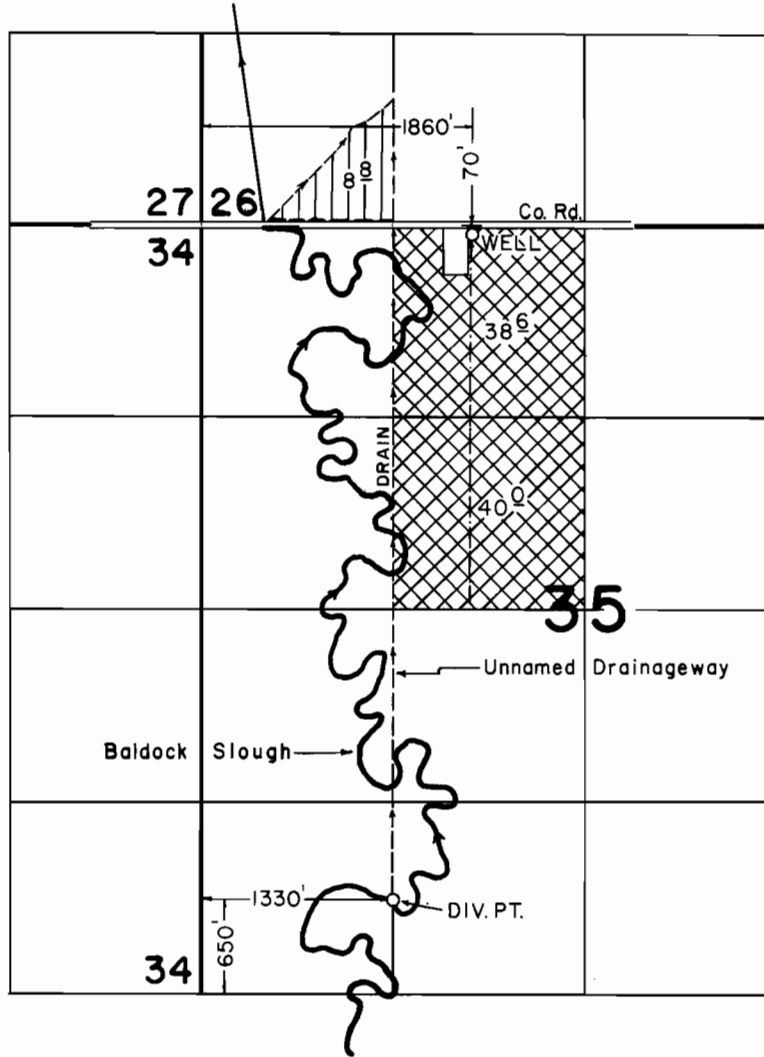

SCALE: 1" = 1320'

## FINAL PROOF SURVEY UNDER

65257

48638



Primary



Suppl'

Application No. G-11022 Permit No. G-10404



Suppl'

IN NAME OF

**BILL G. DAVIS / DONALD B. & JOYCE HART FANCHER**

Surveyed SEPT. 7. 1989, by K. KEMP