


210231  
66634

# T. 6 N. R. 35 E. W.M.

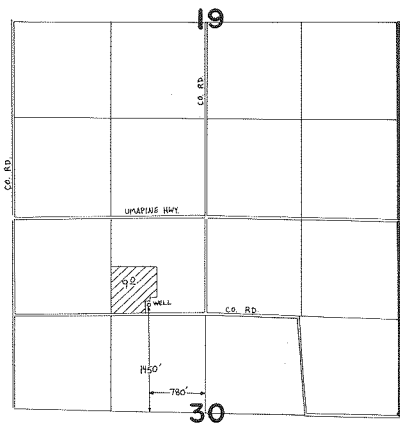

Scale 1" = 1320'



## FINAL PROOF SURVEY UNDER

Application No. G11979.. Permit No. G10231.....  
IN NAME OF

.....DOWNING.....

Surveyed March..16. 1987., by V.Church.....