




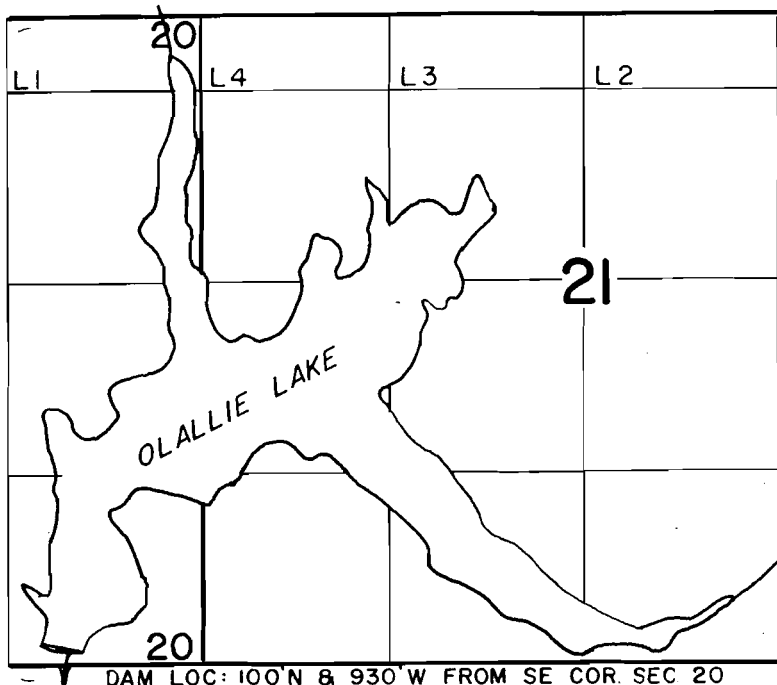

T.10S., R.10W., W.M.

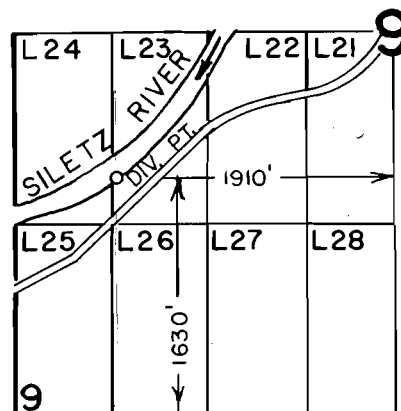

T.11S., R.10W., W.M.

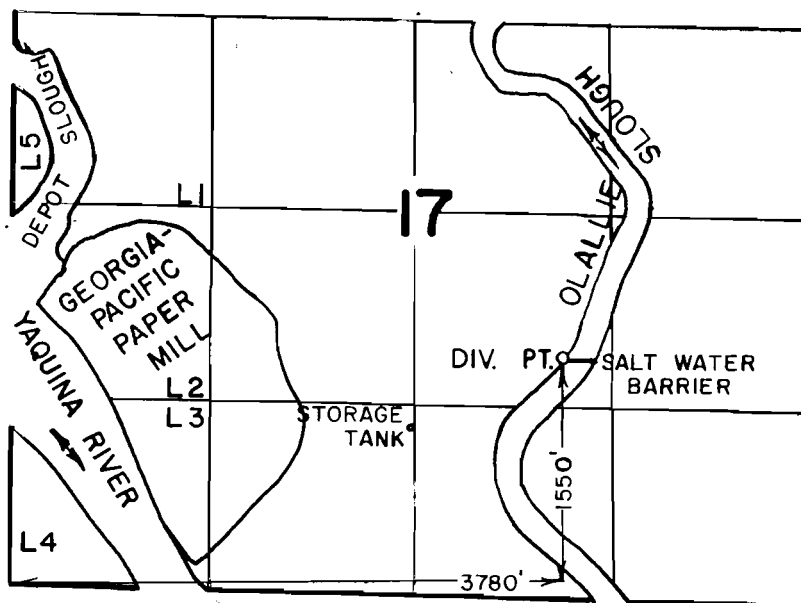

FINAL PROOF SURVEY

38790 UNDER 28789
 R-38789 R-43774 R-3257 R-4892
 43775 R-44442 32147 R-5069
 44443 R-50477 32870 R-5949

Application No. 50478... Permit No. 36715.....

IN NAME OF

GEORGIA-PACIFIC CORPORATION.

Surveyed JUN...3..... 1975., by D...NORBY.....

MAY 21 1991 L. NUNN

LHN
 REVISED 5/22/91
 41041-272-58
 41041-272-55
 DFL-134-148 LHN