


T. 33 S., R. 1 E., W. M.

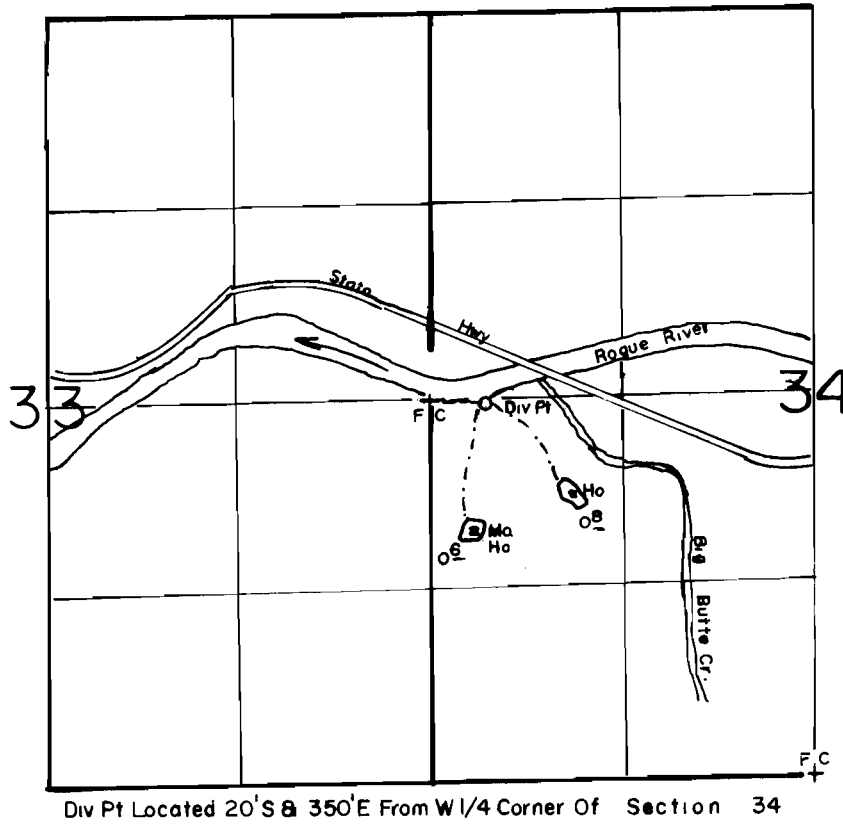

Div Pt Located 20' S & 350' E From W 1/4 Corner Of Section 34

SCALE: 1" = 1320'

**FINAL PROOF SURVEY**  
**UNDER**

Application No. 51173.. Permit No. 38675.....

IN NAME OF

David P. & Carolyn V. Kyzer et al

Surveyed MAY. 14. 1990., by B.S. JAMES.....