


# T.37 S., R.2 E., W.M.

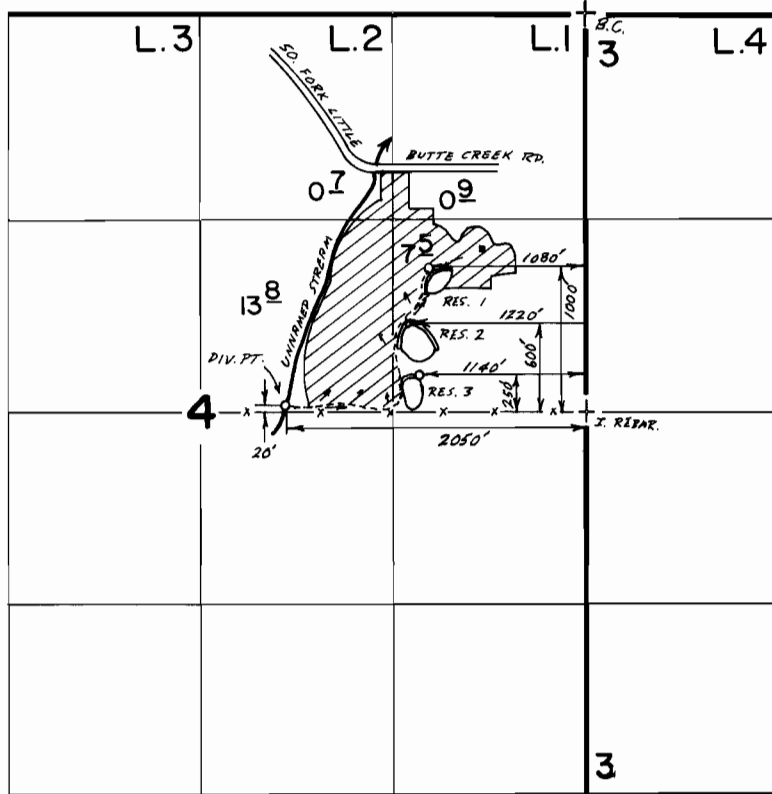

Scale 1" = 1320'

## FINAL PROOF SURVEY UNDER

R-55556                      R-7027

Application No. 55557... Permit No. 42890.....

IN NAME OF

..... A. E. BROWN .....

Surveyed Oct. 2, 1985, by B. S. JAMES.....