


# T.3S. R.10W. W.M.

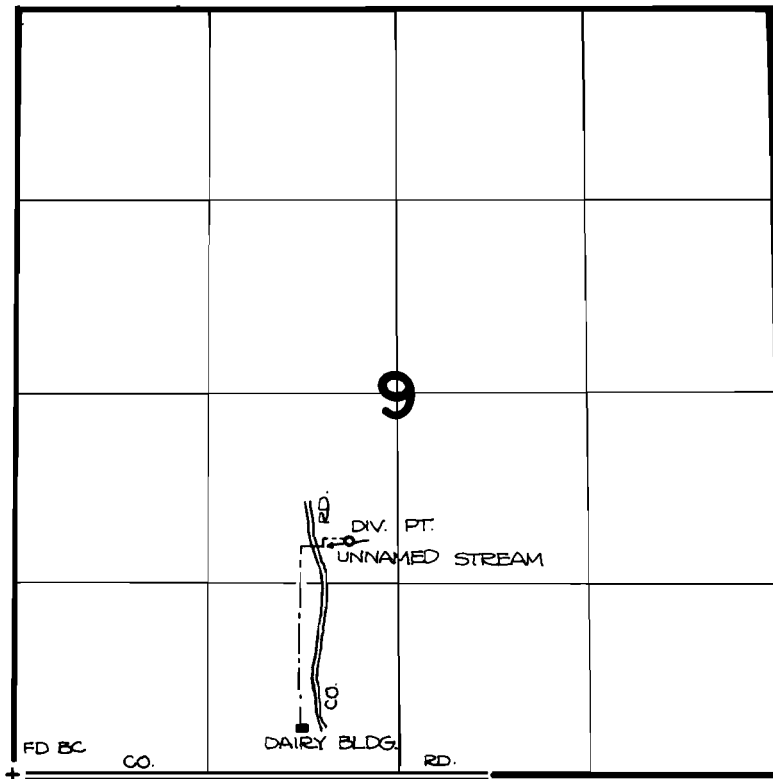

DIVERSION POINT IS LOCATED 1610' N. AND 2300' E. FROM THE S.W. CORNER OF SECTION 9

## FINAL PROOF SURVEY UNDER

Application No. ~~58706~~ Permit No. ~~44660~~....  
IN NAME OF

**JOHN GREEN**

Surveyed **OCT. 26, 1983**, by *P.R. Pugh*.....