


46427
46652
(R-8347)

T.33S., R.17E., W. M.

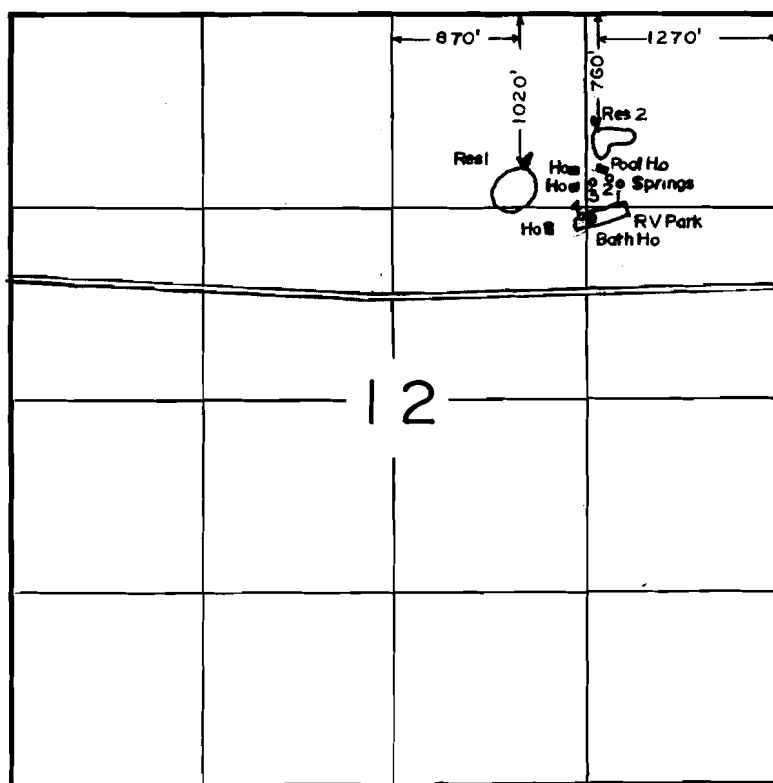

Springs Loc; 1- 1150'S & 1080'W, 2- 1120'S & 1150'W, 3- 1150'S & 1270'W, 4- 1400'S & 1350'W All From The NE Corner

SCALE: 1"=1320'

FINAL PROOF SURVEY

UNDER

R-59957

R- 8347

Application No. 59457... Permit No. 46427.....
IN NAME OF

E.D. McDANIEL.....

Surveyed JULY 24... 1989.., by B.W. BISHOP.....