


T.33S.,R.17E.,W. M.

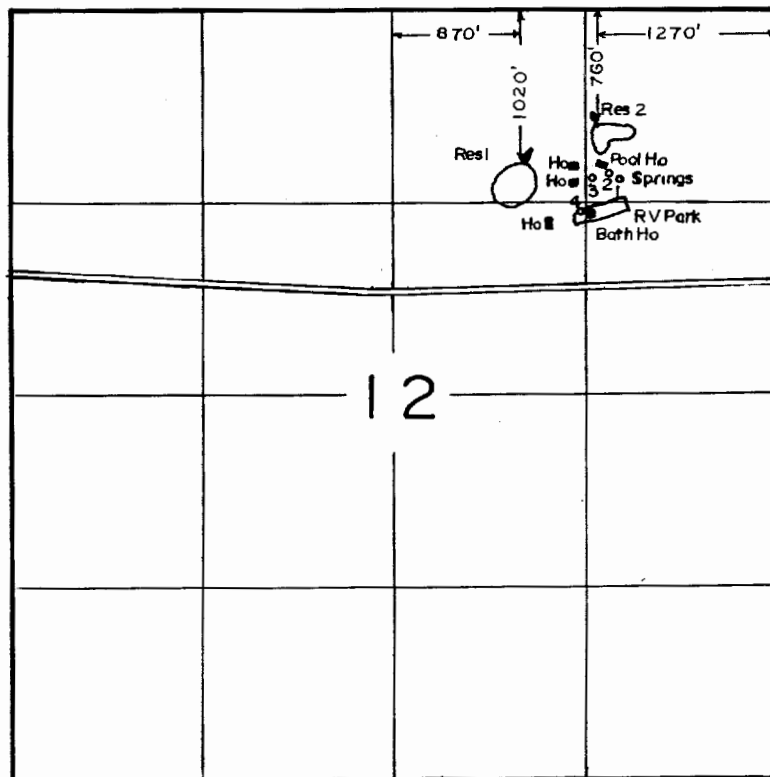

Springs Loc: 1- 1150'S & 1080'W, 2-1120'S & 1150'W, 3-1150'S & 1270'W, 4-1400'S & 1350'W All From The NE Corner

SCALE: 1"=1320'

FINAL PROOF SURVEY UNDER

R-59957

R- 8347

Application No. 59457... Permit No. 46427.....
IN NAME OF

.....E.D. McDANIEL.....

Surveyed JULY 24... 1989., by B.W.BISHOP.....