


Exhibit - B

RECEIVED
JUL 20 1981
WATER RESOURCES DEPT
SALEM, OREGON

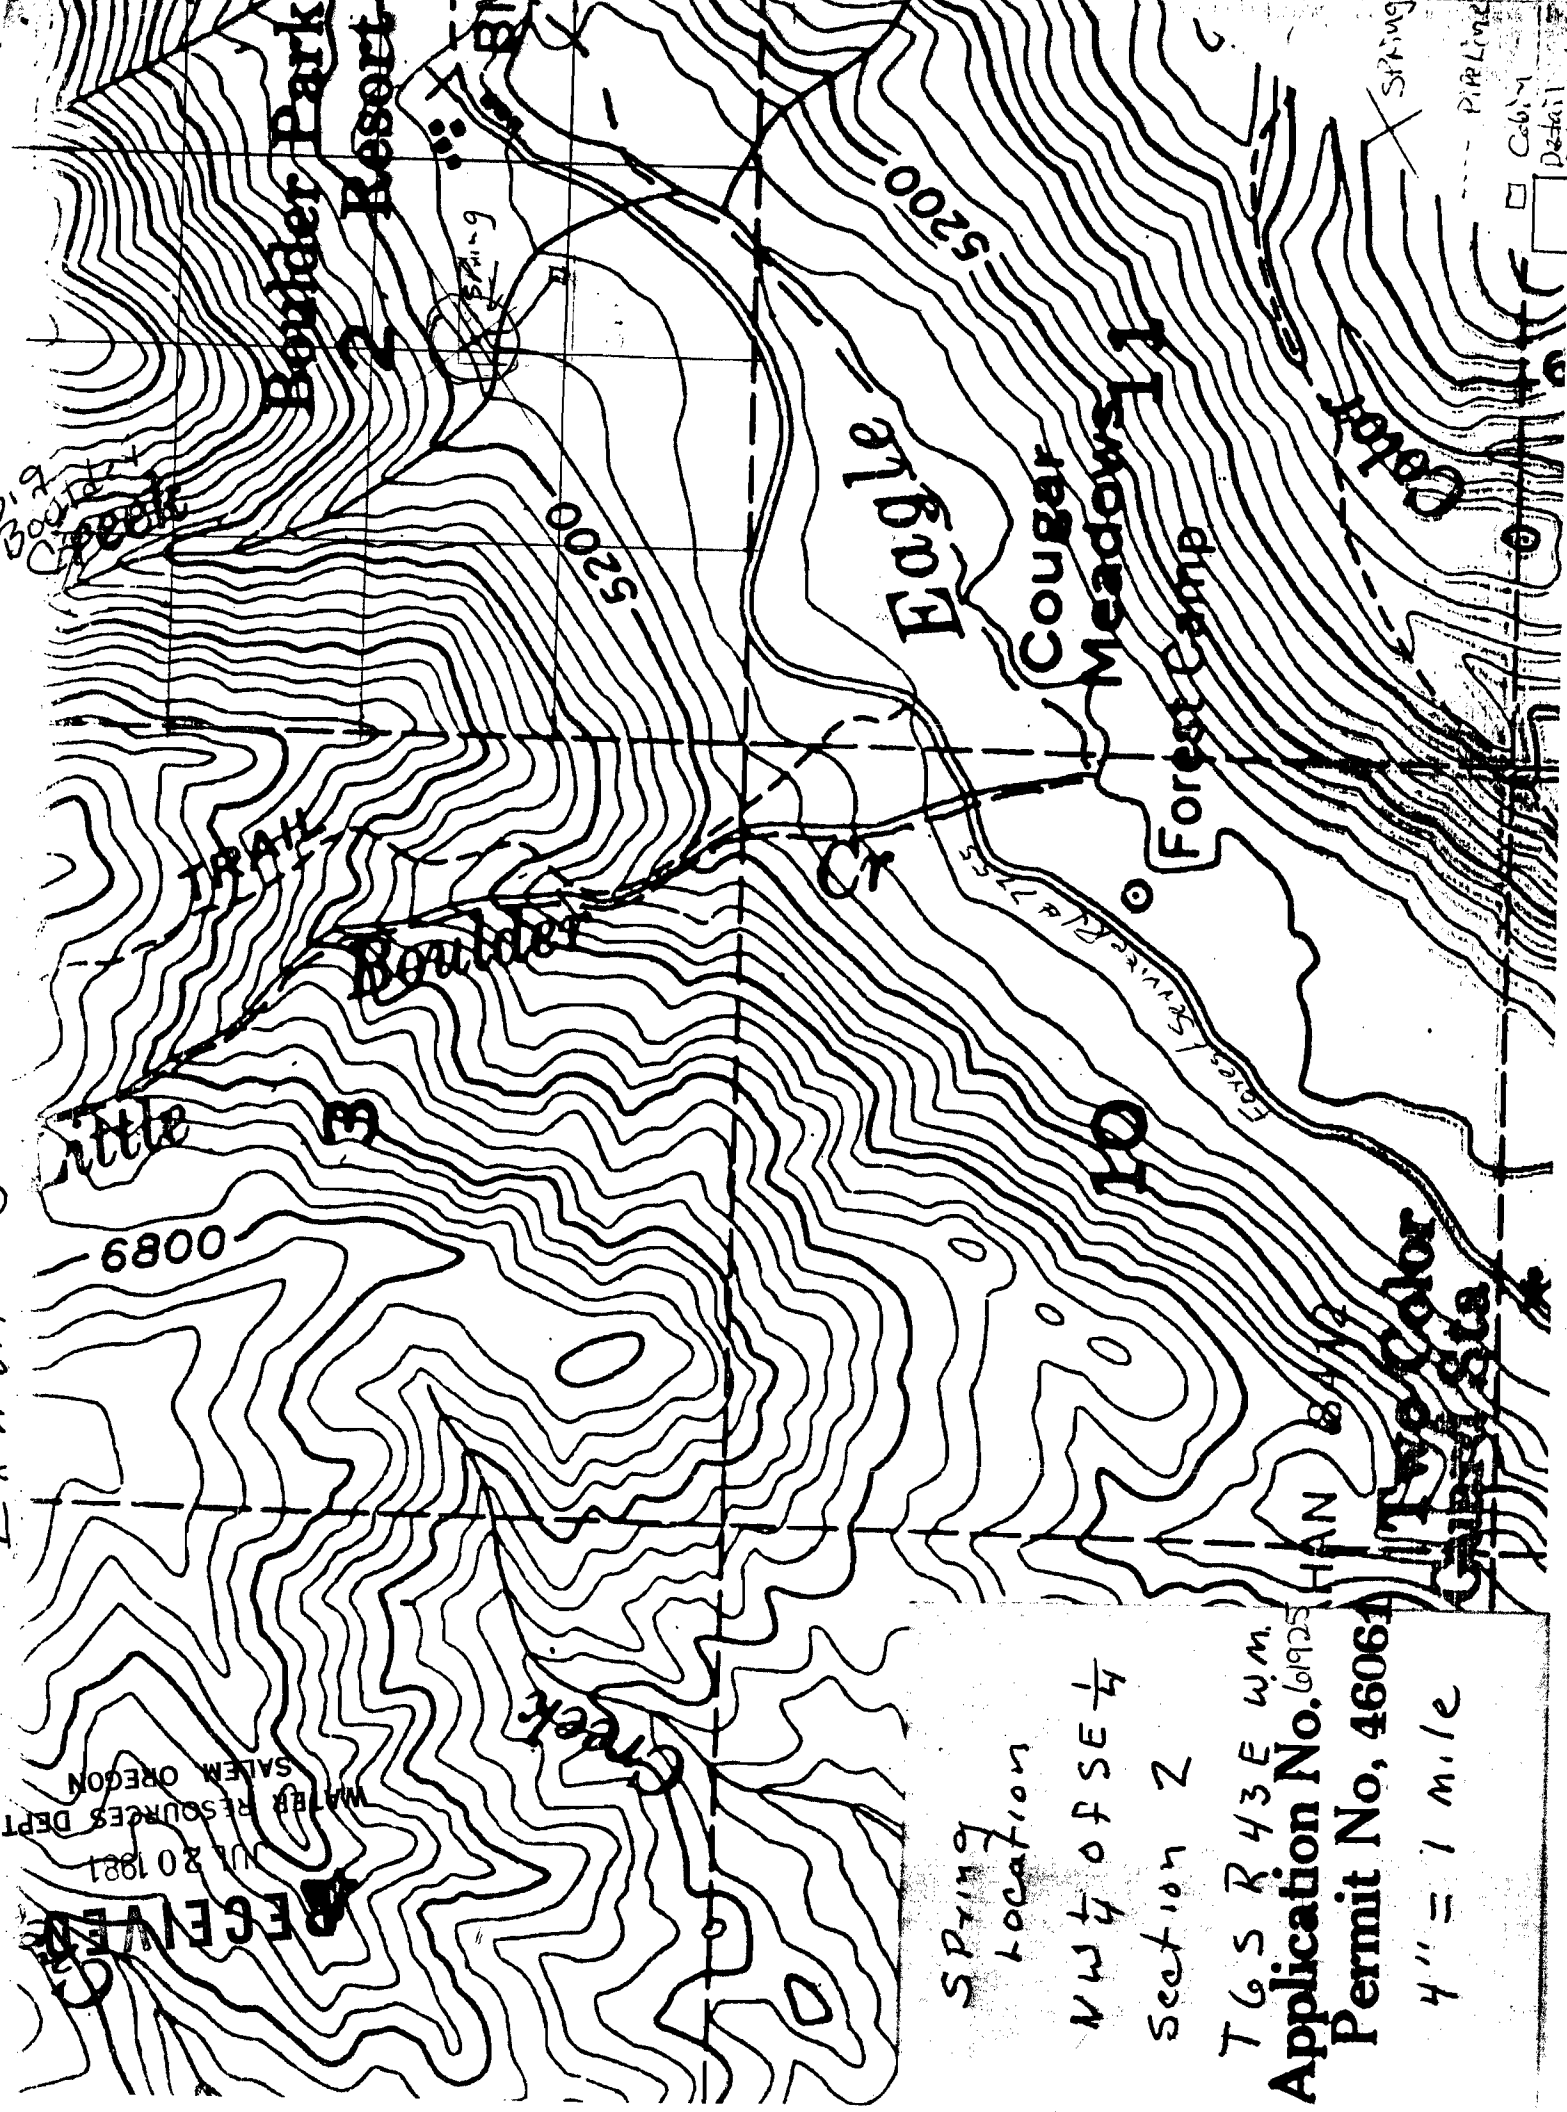

Spring
Location
NW 1/4 of SE 1/4
Section 2

T6 S R 43 E W.M.
Application No. 60925
Permit No. 46061
4" = 1 mile

Typ Color
Guest Sta

Spring
Pipe Line
Cabin
Detail