


100
R 17 EWM

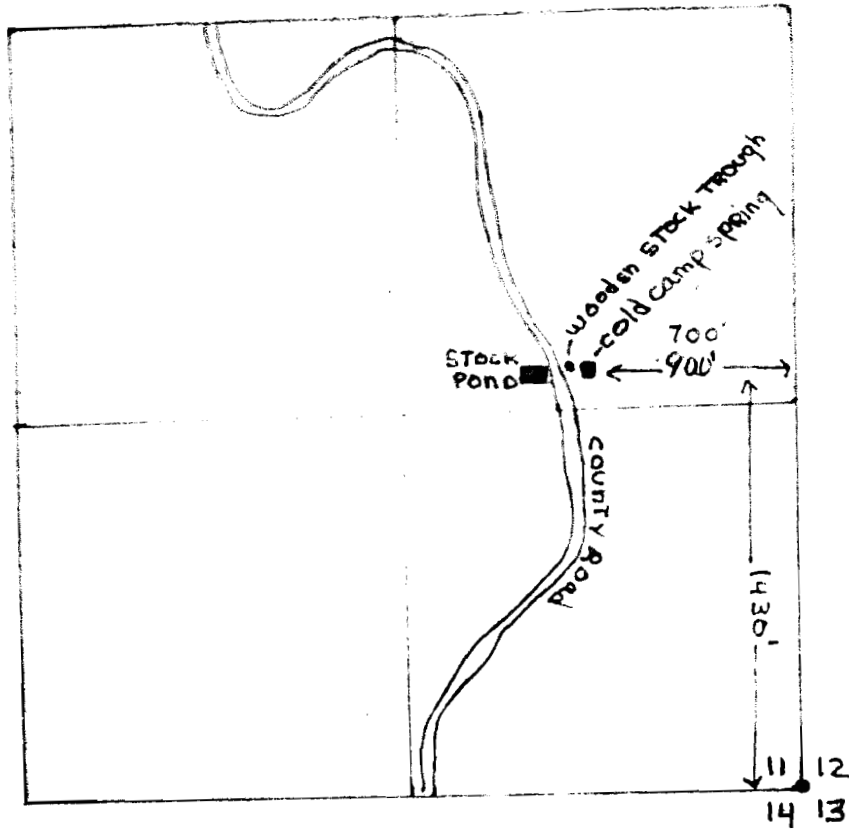

Scale - 6" = 1 mile

RECEIVED
WATER RESOURCES DEPT.
SALEM, OREGON

RECEIVED

APR 29 1983

WATER RESOURCES DEPT.
SALEM, OREGON

C-66658

Application No 63599

Permit No.

RECEIVED

MAR 3 1983

WATER RESOURCES DEPT.
SALEM, OREGON

RECEIVED

JAN 4 1983

WATER RESOURCES DEPT.
SALEM, OREGON

James G. Perkins
Shirlee D. Perkins
Mc Rae Ranch
Clarno, Oregon
47446

Application No. 63549, R-64907

Permit No. 47446

R 8668