


T. 34 S., R. 1 W., W.M.

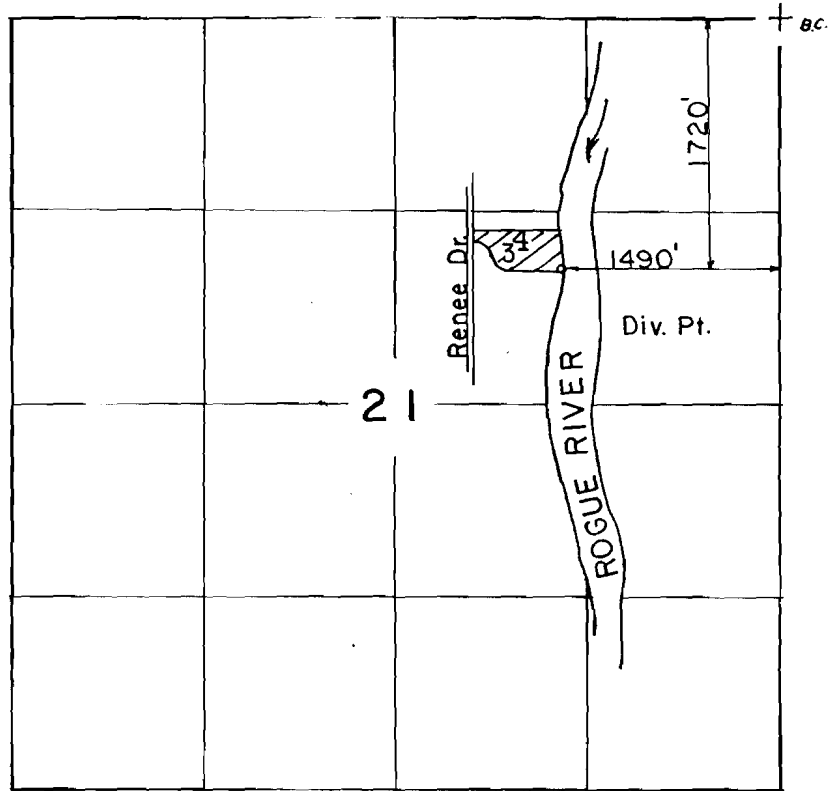

Scale: 1" = 1320'

FINAL PROOF SURVEY
UNDER

Application No. 64155... Permit No. 47132.....
IN NAME OF

.....BELL.....

Surveyed APR. 17, 1990., by B. S. JAMES.....