


# T. 40 S., R. 7 W., W.M.

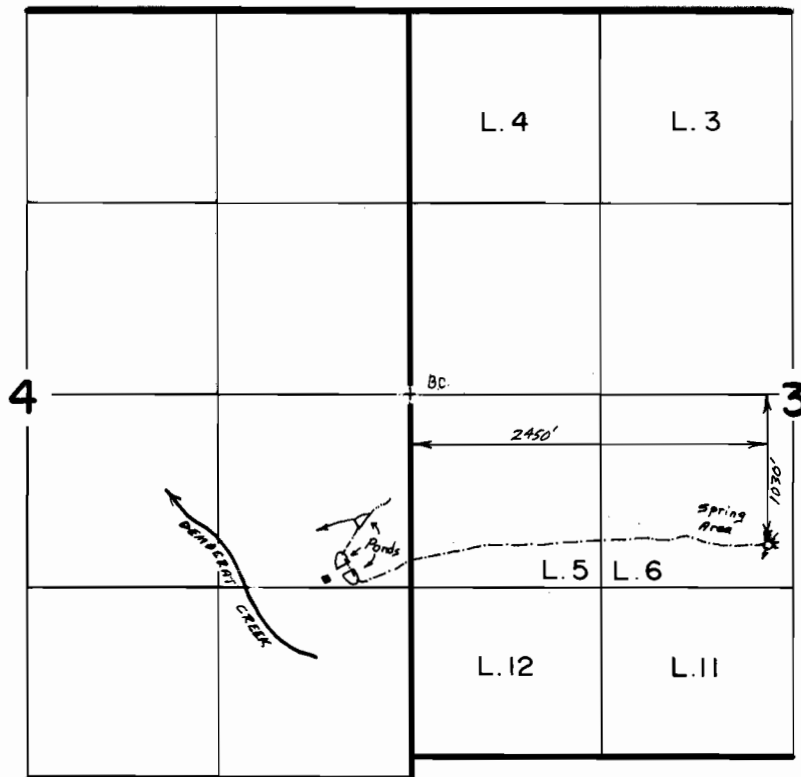

Scale: 1" = 1320'

## FINAL PROOF SURVEY UNDER

Application No. 64796 Permit No. 47545  
IN NAME OF

CHARLIE TREFETHEN

Surveyed MAY...15.. 19.8.6, by B...S...JAMES...