


T. 8 S., R. 46 E., W.M.

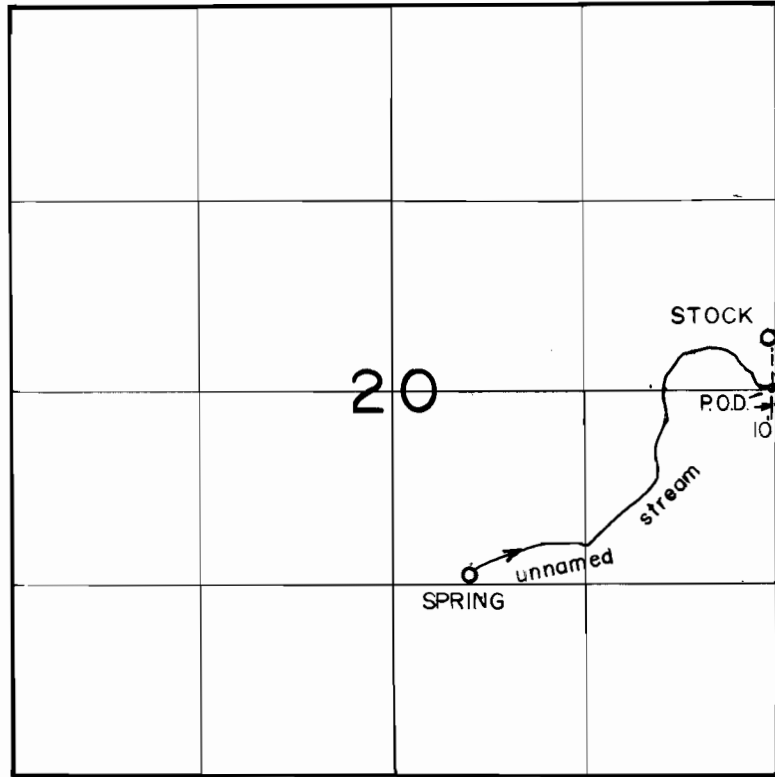

1" = 1320'



**FINAL PROOF SURVEY
UNDER**

Application No. 65191 Permit No. 47845
IN NAME OF

GOVER & SONS

Surveyed MAY 22 19.90, by V. L. CHURCH