


# T. 26 S., R. 5 W., W.M.

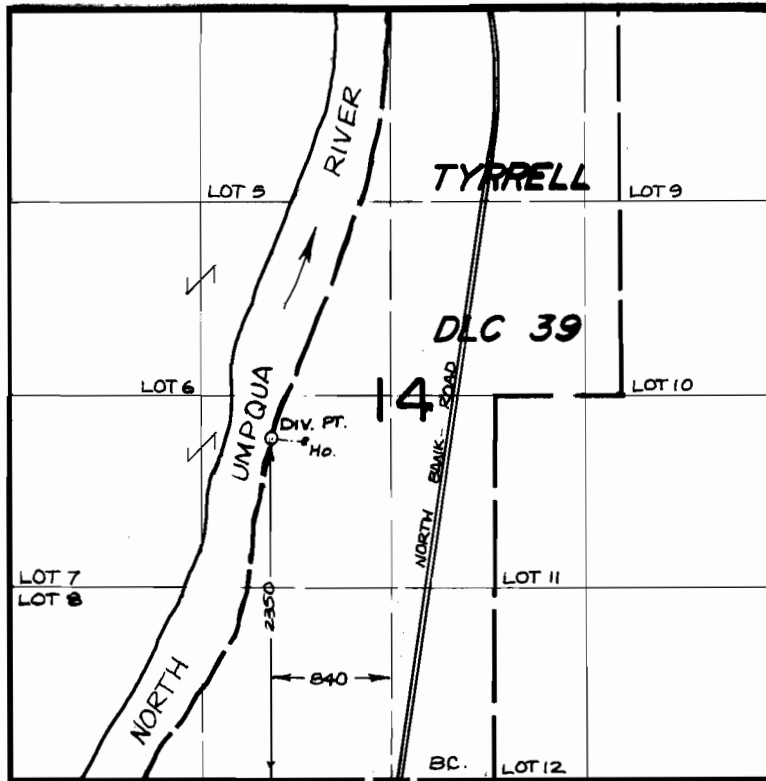

SCALE : 4" = 1 MILE

## FINAL PROOF SURVEY UNDER

Application No. 68439 Permit No. 49422...  
IN NAME OF

**FRED H. HOWELL**

Surveyed OCT. 9, 19.86, by J.M. SCHMORDE