



T. 21 S., R. 5 W., W.M.

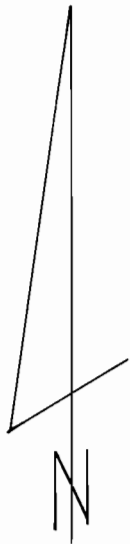

1" = 1320'

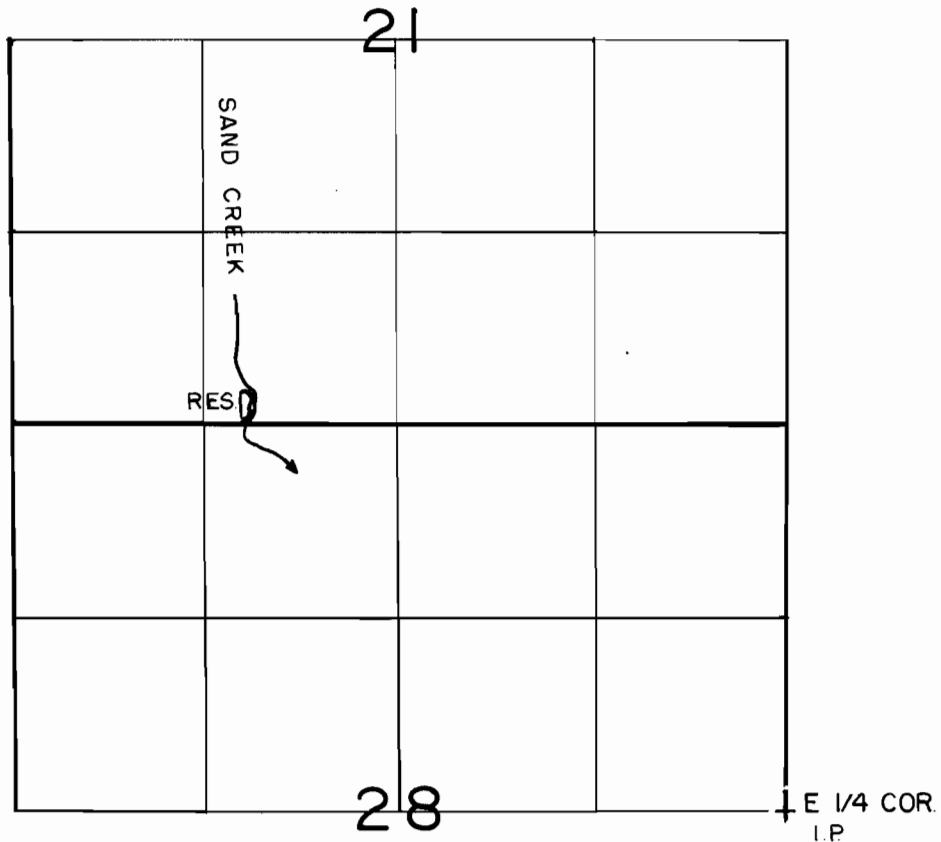

FINAL PROOF SURVEY
UNDER

Application No. R-68950 Permit No. R-10826

IN NAME OF

CARL W. KIMPTON

Surveyed SEPT. 14 1990, by B W BISHOP

1-23-91 DSM
21S-5W-SW