


# T. 38 S., R. 4 W., W. M.

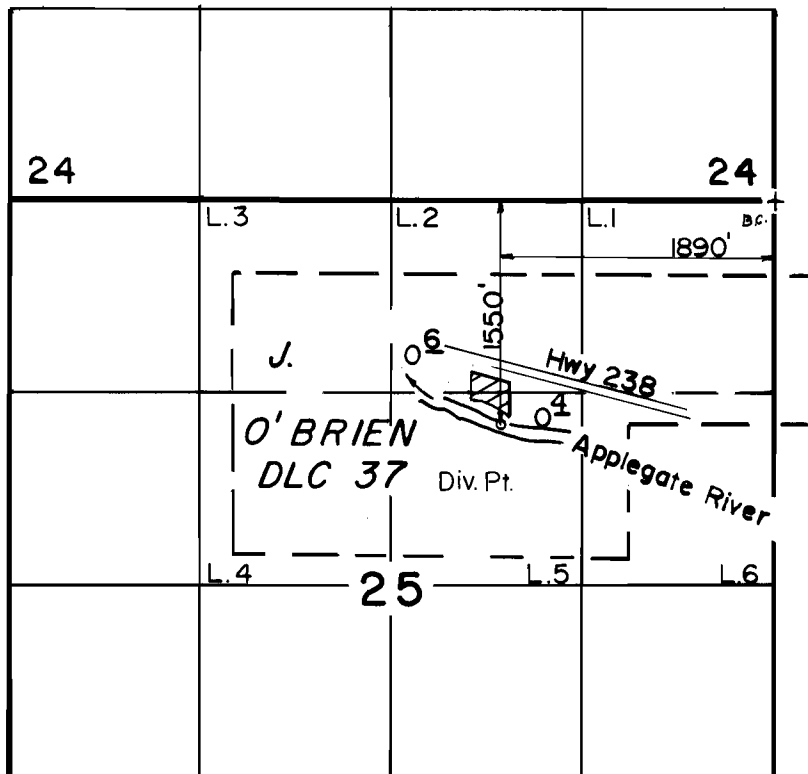

Scale: 1" = 1320'

## FINAL PROOF SURVEY UNDER

Application No. 69090 Permit No. 50108....  
IN NAME OF

.....JACK E. DOWNS.....

Surveyed AUG. 3. 1988., by B. S. JAMES....