

FINAL PROOF SURVEY under

Application No. R - 69785 & 69422

Permit No. R - 11056 & 50592

in the name of WILLIAM R. SMITH WATER RESOURCES DEPT

in T 40 S, R 14 W, Section 10, W. M. SALEM, OREGON


Curry County, Oregon.

scale: 1" = 400'


May 9, 1990

RECEIVED

JUL 25 1990

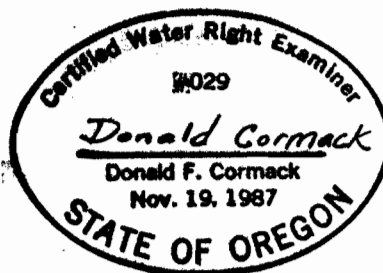

NOTE: the purpose of this map is to identify the location of the water right. It is not intended to provide information relative to the location of property ownership boundary lines.

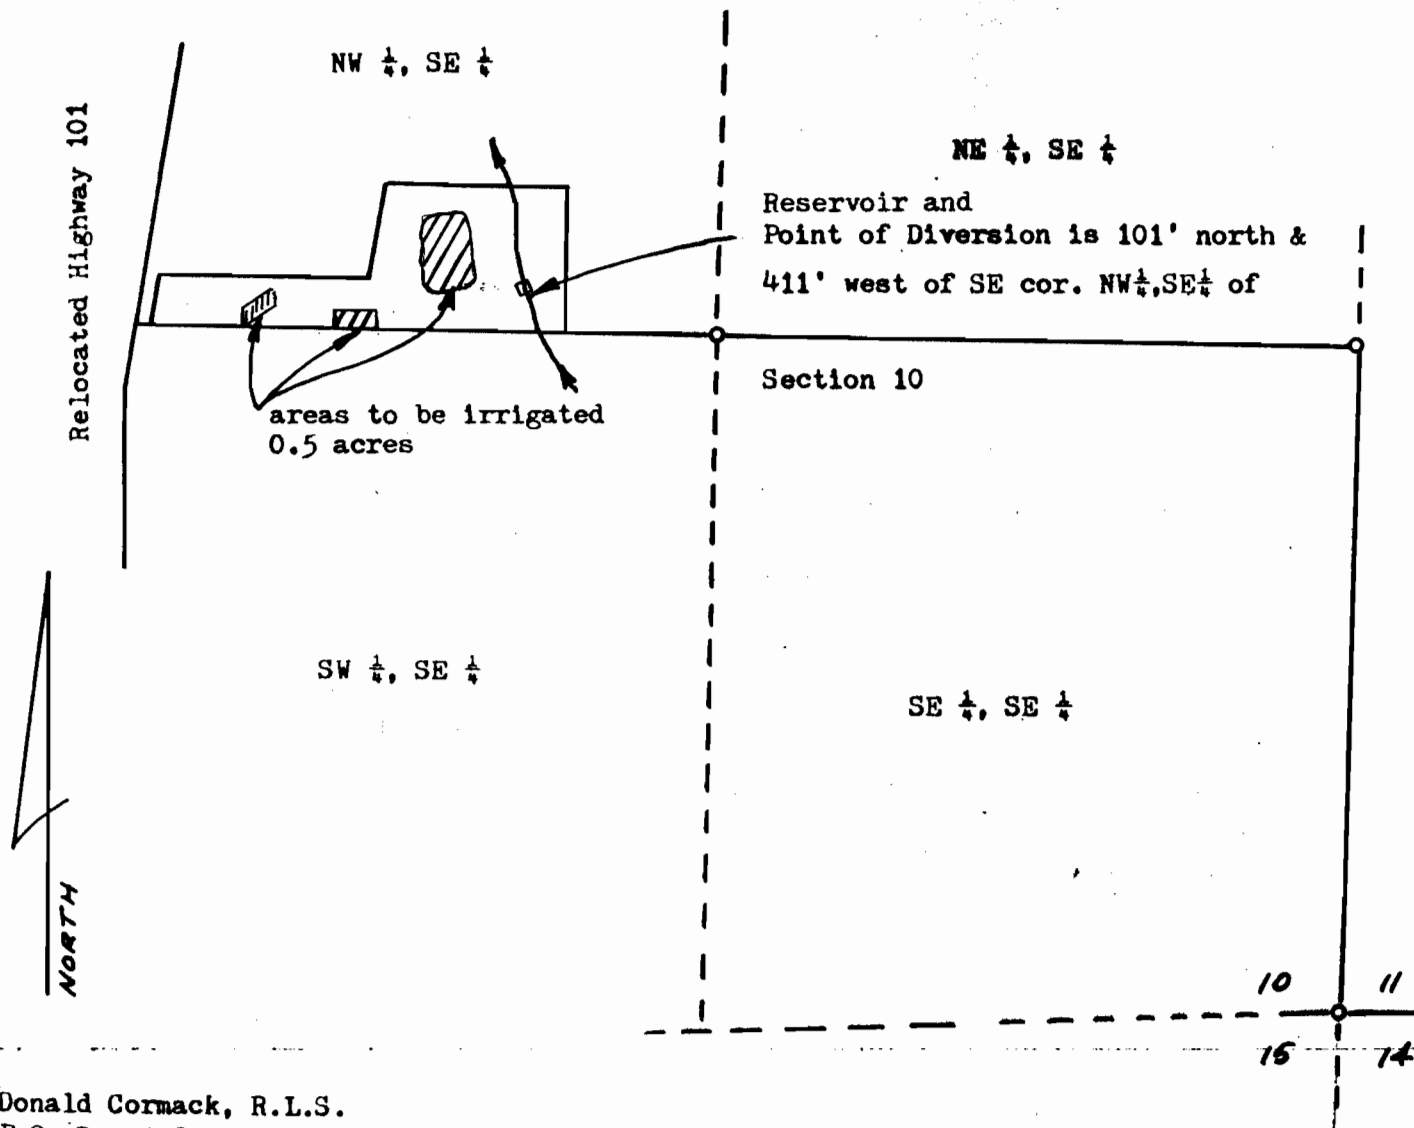

Donald Cormack, R.L.S.
P.O. Box 1280
Brookings, Oregon, 97415
469 - 3349