


T. 30S.R.14&15WWM

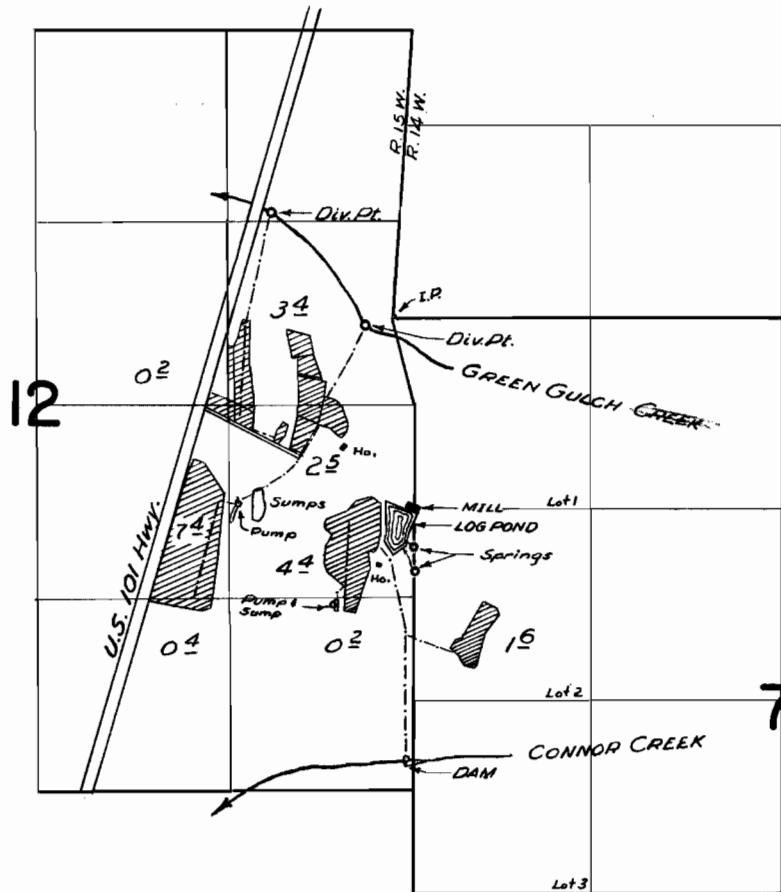

FINAL PROOF SURVEY UNDER

Application No. 19862 Permit No. 15439

IN NAME OF
L.M. & ETHEL M. KRANICK
E.W. & MABEL S. HUGHES

24 APRIL 1958

Surveyed 14 JUNE 1960, by M. Bish

1958-A
1960-C