


T. 18S., R. 44 & 45E., W.M.

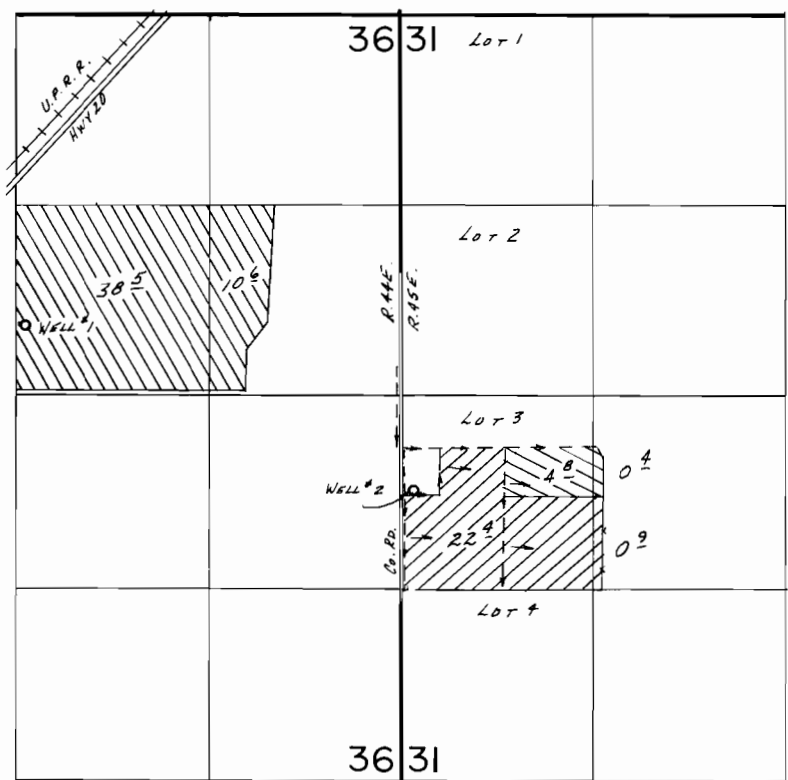


WELLS LOC: #1-470' N. & 60' E. FROM C/4 COR. SEC. 36, T. 18S., R. 44E., W.M.
 #2-650' S. & 80' E. FROM W/4 COR. SEC. 31, T. 18S., R. 45E., W.M.

SCALE: 1" = 1320'

FINAL PROOF SURVEY UNDER

Application No. G-11009 Permit No. G-10118
 G-11015 G-10120

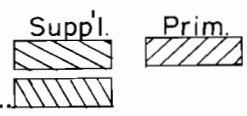

IN NAME OF
 JOHN C. ELFERING

Surveyed Apr. 28, 1986, by L.M.TOLL.....

3/13/87 BwB
 41045-478-62R
 PTS 1986V-A