


T.3S., R.1E., W.M.

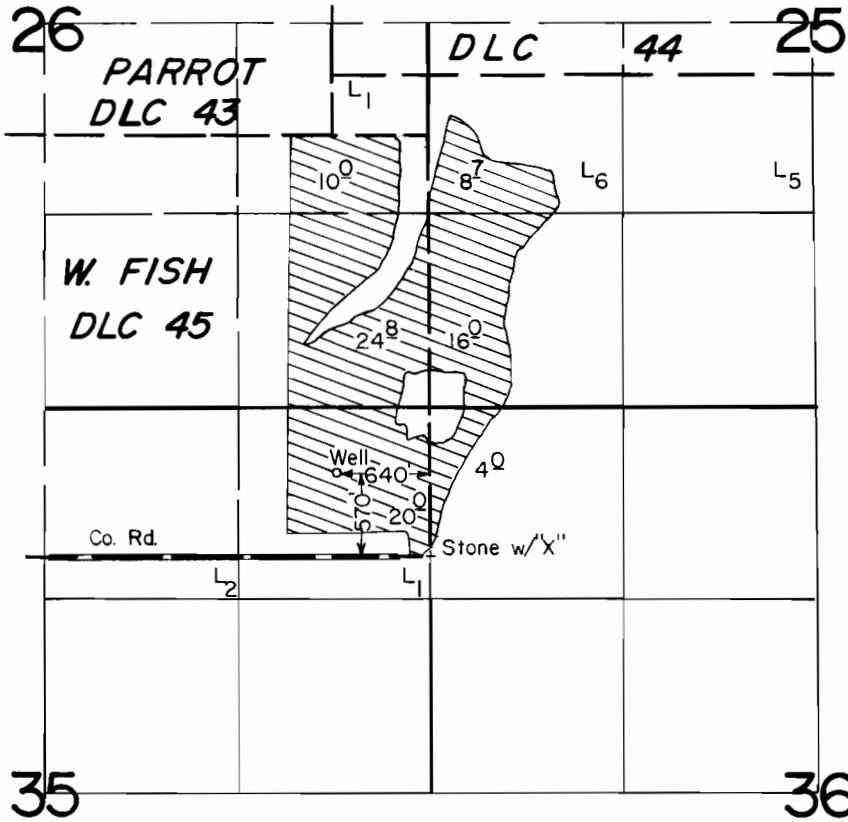

Scale: 1" = 1320'

FINAL PROOF SURVEY UNDER

Application No. G-11477.. Permit No. G-10548...
IN NAME OF

PAUL & JUDY SEIFORT & DAVE OBRIST

Surveyed JULY 31, 1986., by T. Warren.....