

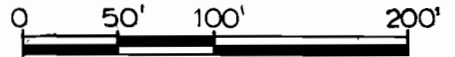


- LEGEND**
- 1", 1-1/2", 2", 3" PVC PIPE
  - 1-1/4" GALV. IRON PIPE
  - BURIED PIPE MAINS
  - PROPERTY LINE
  - ⊕ WELL POINT SOURCE

SCALE: 1" = 100'

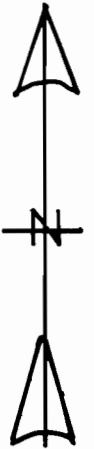

THIS MAP IS PREPARED ONLY FOR USE IN IDENTIFYING THE LOCATION OF THE PROPOSED WATER RIGHT. NO USE FOR LOCATING PROPERTY OWNERSHIP BOUNDARY LINES IS INTENDED.

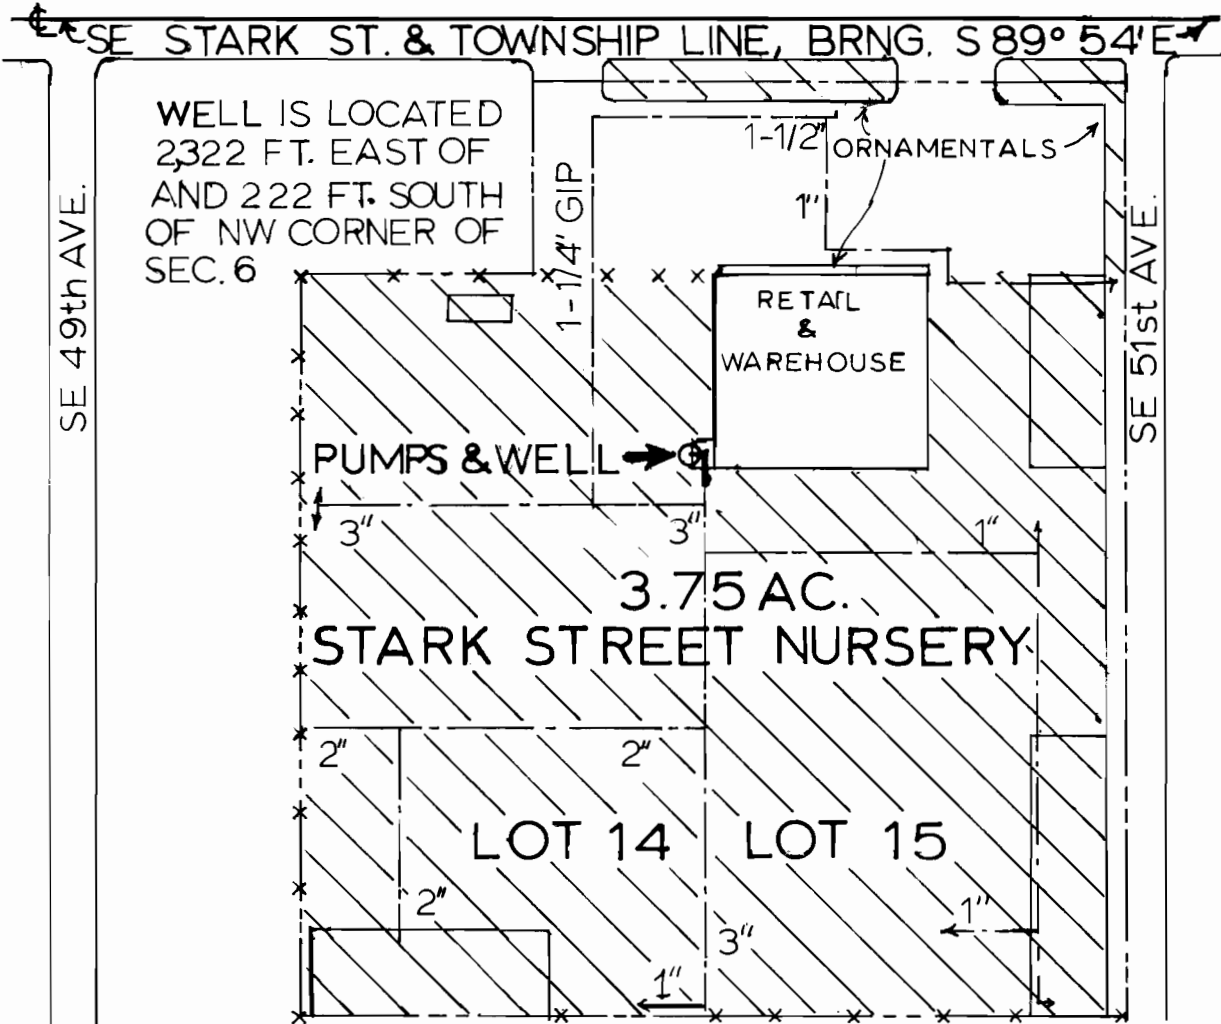

T1S R2E, SEC 6 NE1/4NW1/4  
**FINAL PROOF SURVEY**  
 UNDER  
 Application No. G-11694 Permit No. G-10780  
 IN NAME OF  
**STARK STREET NURSERY, dba**  
 JON J. DENNEY  
 H. R. DENNEY

Surveyed: FEB. 6, 1990 By: J. RICHMOND

*John C. Richmond*