


T.3S., R.2W., W.M.

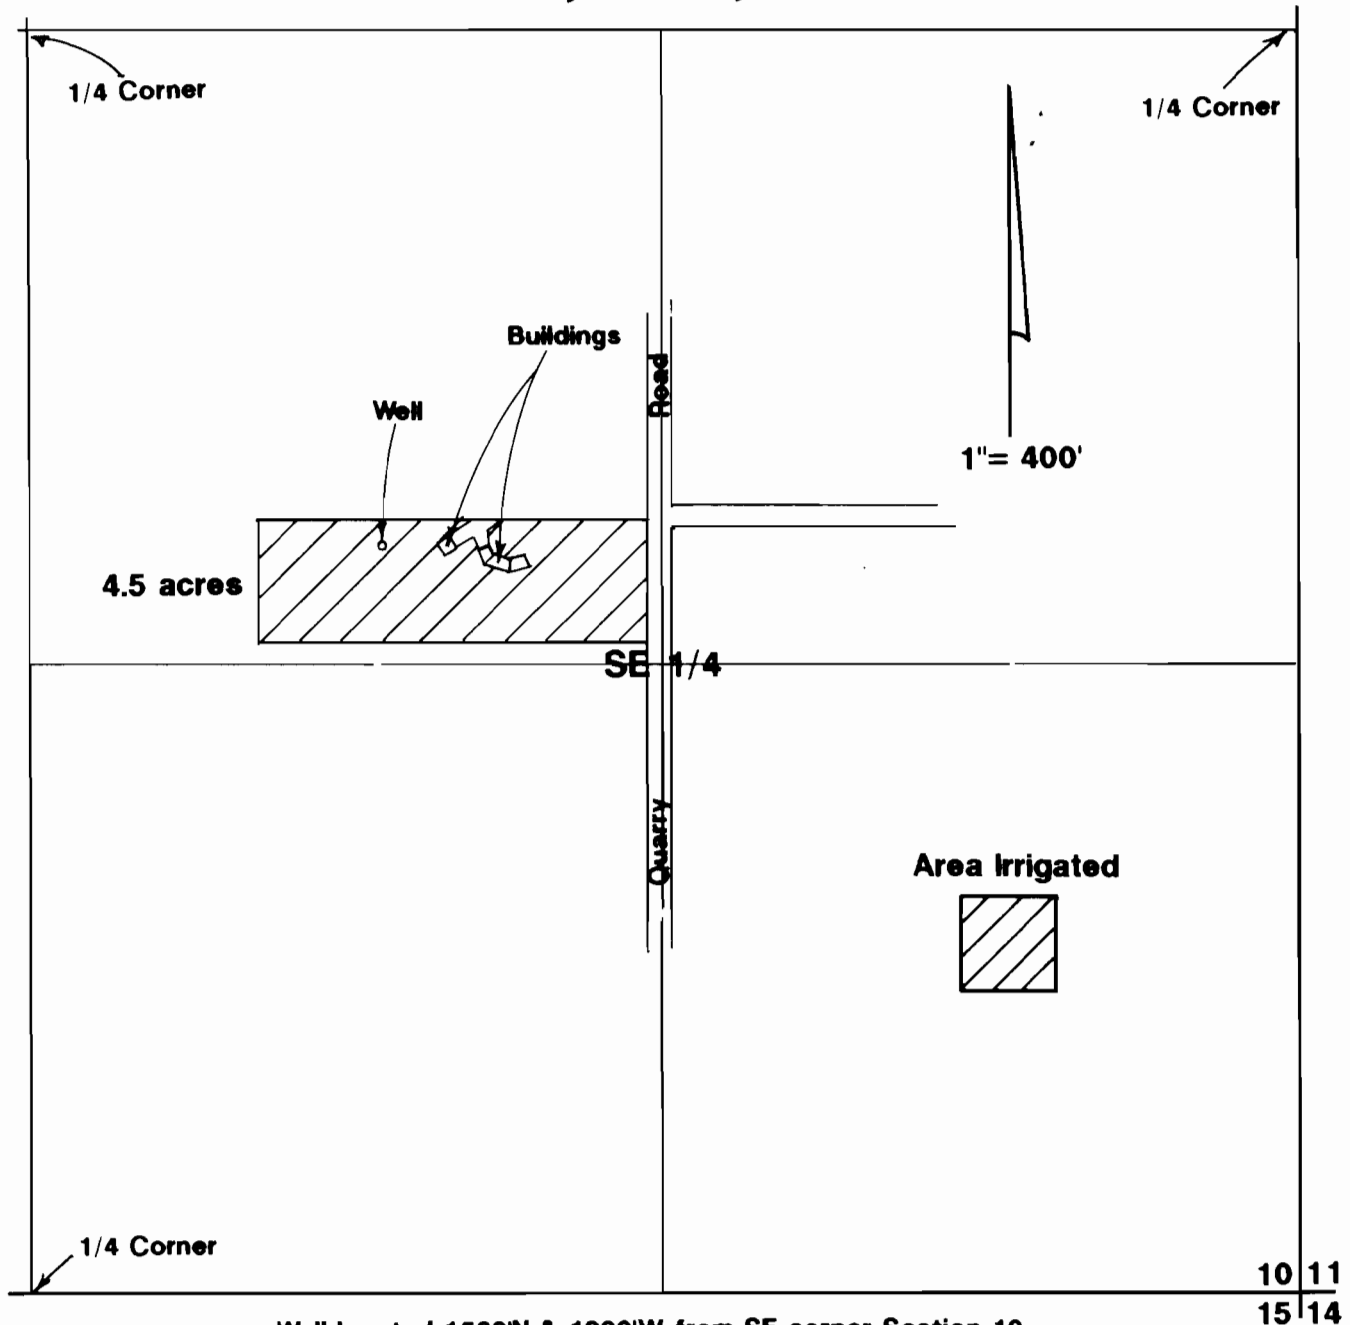

Final Proof Survey

Application #: G-11862 Permit #: G-10944

In Name Of

Curtis & Theresa Ellson

Surveyed on January 12, 1991 by JM Schuette

RECEIVED

APR 11 1991

**WATER RESOURCES DEP
SALEM, OREGON**



THIS MAP WAS PREPARED FOR THE PURPOSE OF IDENTIFYING THE LOCATION OF A WATER RIGHT ONLY AND IS NOT INTENDED TO PROVIDE LEGAL DIMENSIONS OR LOCATION OF PROPERTY OWNERSHIP LINES.