


66682

T 39 S R 13 E

Section 29

4" = 1 mile

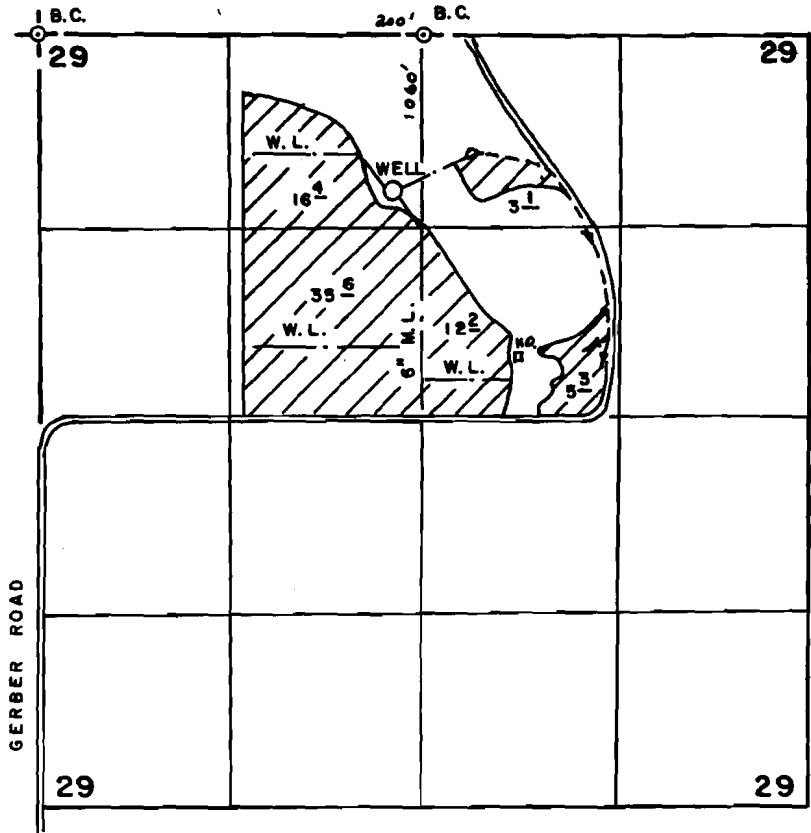


*Miller Creek & Misc. Wells*

APPL. # G-12060

CLAIM OF BENEFICIAL USE MAP

for

Gerald Don & Lorna L. Douglas

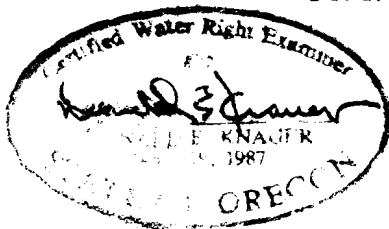

This map is for water right information only.

Photo # WAC-8502 8-145