


T. 6N., R. 35E., W.M.

WASH.
ORE.

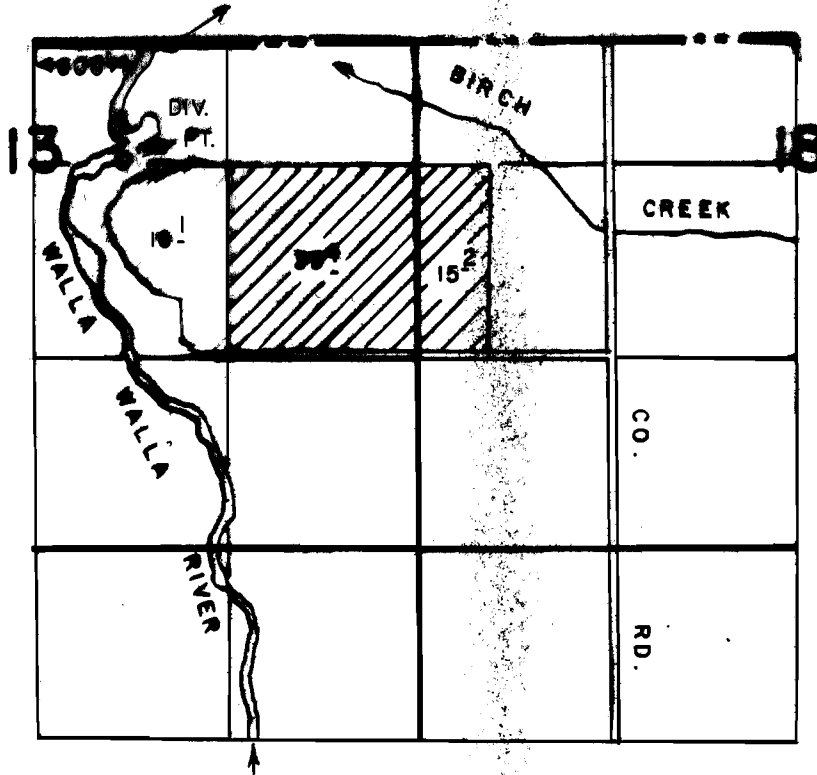

1" = 1320'

FINAL PROOF SURVEY
UNDER

Application No. 55795 Permit No. 42333
IN NAME OF

BUD BIER

Surveyed JAN. 7 1990 by V.L. CHURCH

3-30-90 DSM
41059-378-255R