


T27S, R4W, WM

JAN 14 1991

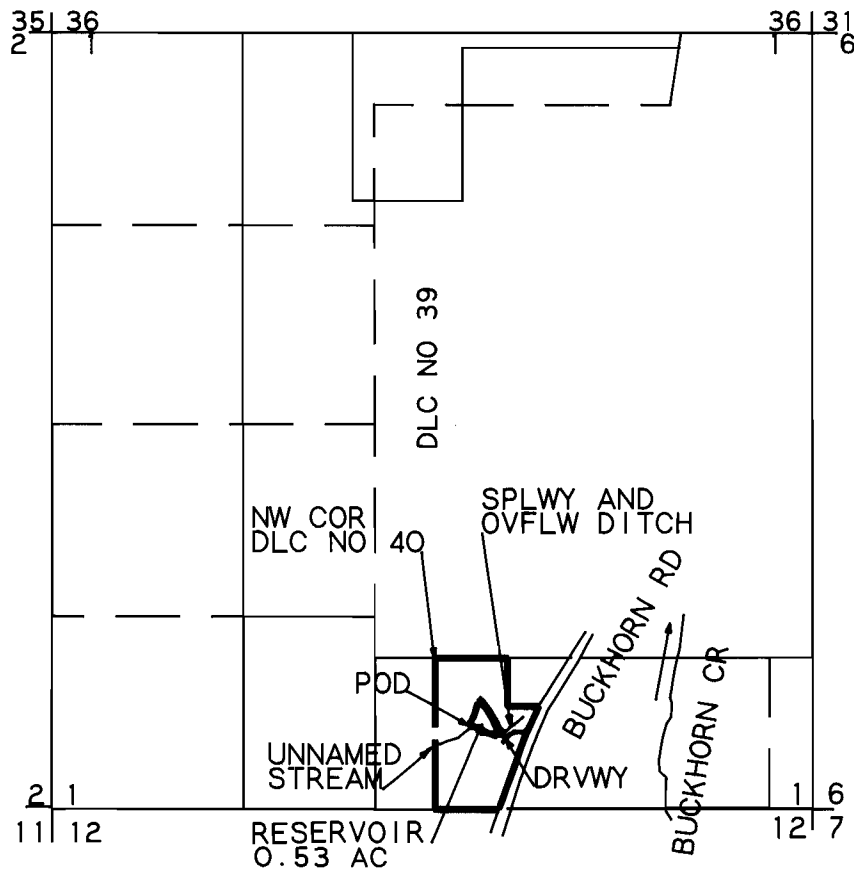

POD 560 FT N AND 2360 FT W OF SE COR SEC 1

FINAL PROOF SURVEY


UNDER

Application No. R-69401 Permit No. R-11034

IN NAME OF

MERRILL D. OR SUSAN L. TESTER

Surveyed March 24, 1990 BY M E Farr

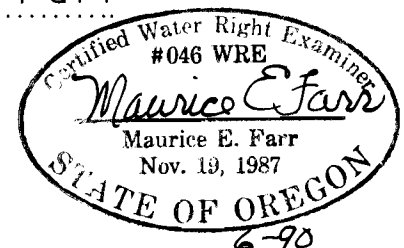


T27S.R4W.WM
CLAIM OF BENEFICIAL USE
AND SITE REPORT


APPLICATION NO. R-69401
PERMIT NO R-11034

MERRILL D OR SUSAN L TESTER


SPILLWAY DISCHARGE
VS DEPTH OF FLOW

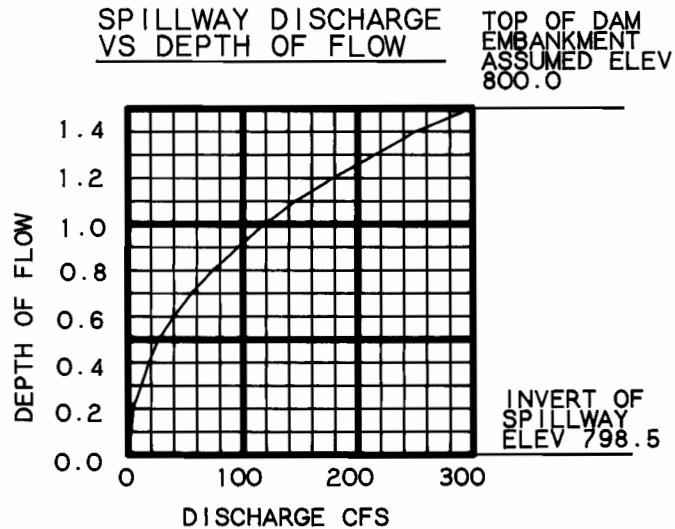

CROSS SECTION OF SPILLWAY

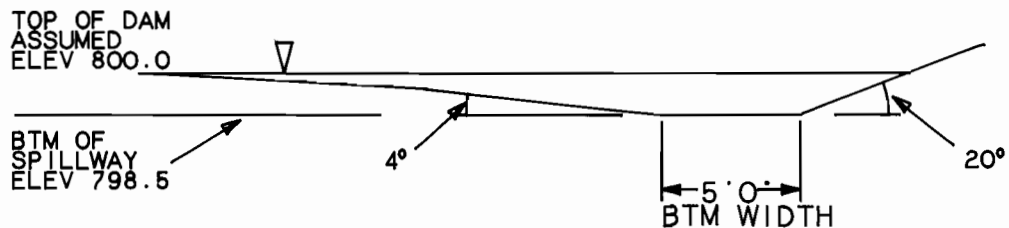

TYPICAL CROSS SECTION OF DAM EMBANKMENT

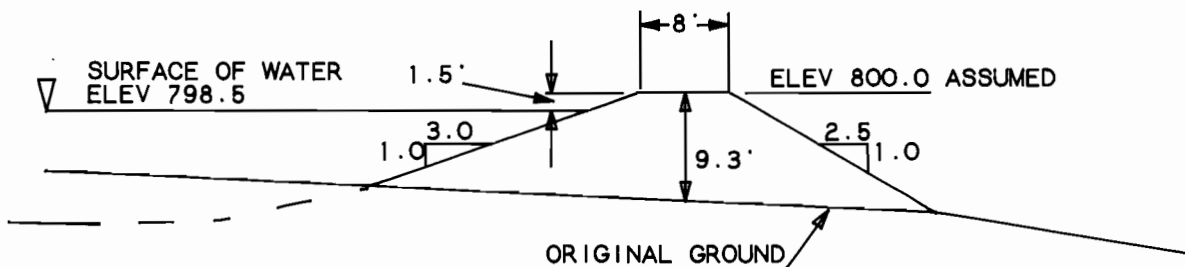

RESERVOIR AREA WAS DEEPEMED APPROXIMATELY
5 FEET FOR EXTRA STORAGE



6-98