

T 29 S, R 12 W. W.M. S. 31 & 32


FINAL PROOF SURVEY

UNDER

Amended Application No. 69426,

Permit No. 50197

Scale 1" = 400 FT

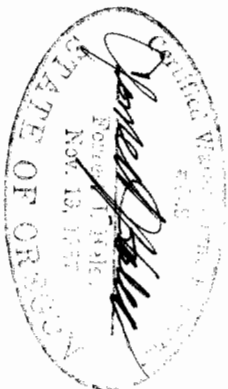

Surveyed 9-9-89
F.H.H.

