


THIS MAP WAS PREPARED FOR THE PURPOSE OF IDENTIFYING THE LOCATION OF THE WATER RIGHT AND IS NOT INTENDED TO PROVIDE LEGAL DIMENSIONS OR LOCATIONS OF PROPERTY OWNERSHIP LINES.

000 117 1000

T1N, R6W, W.M.

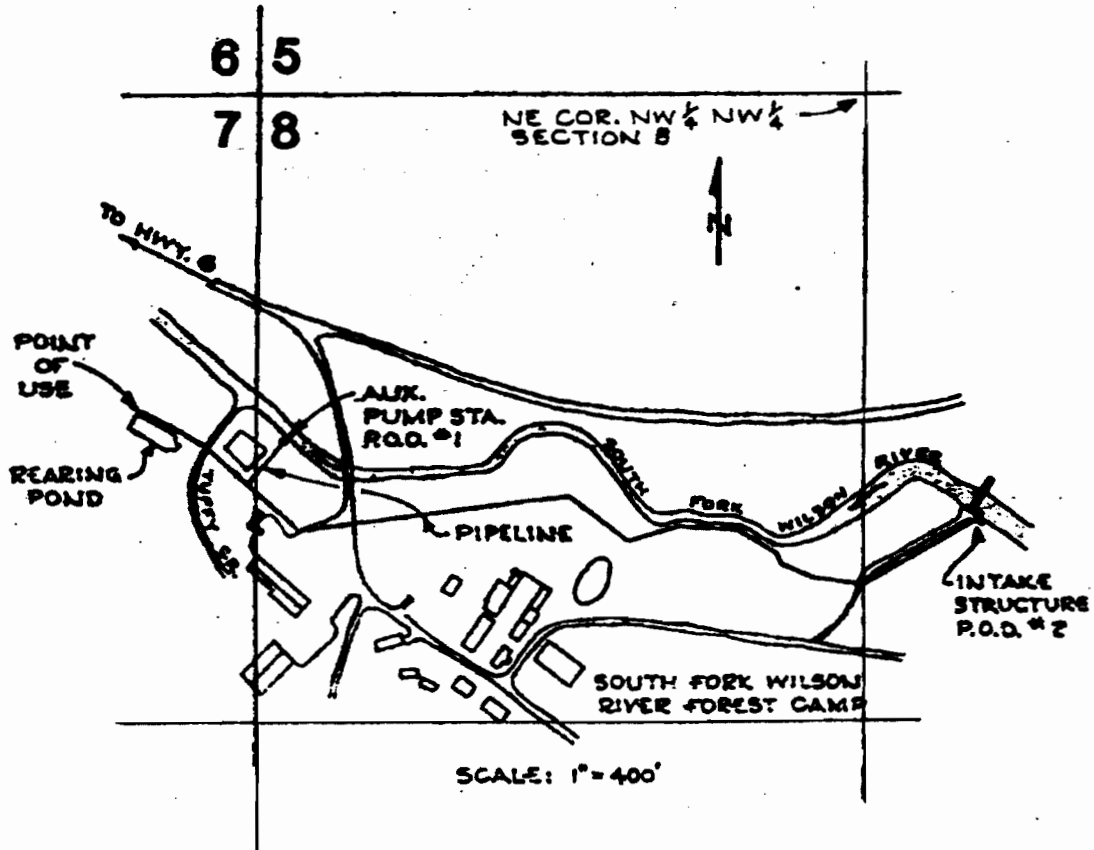

- #1 POD LOCATED 732' S AND 62' E FROM NW CORNER OF SECTION 8
- #2 POD LOCATED 880' S AND 1700' E FROM NW CORNER OF SECTION 8

FINAL PROOF SURVEY

UNDER

APPLICATION NO 69639 PERMIT NO 50858

IN NAME OF

OREGON DEPARTMENT OF FISH AND WILDLIFE

SURVEYED NOV 1, 1990

BY DODGE

