


THIS MAP WAS PREPARED FOR THE PURPOSE OF IDENTIFYING THE LOCATION OF THE WATER RIGHT AND IS NOT INTENDED TO PROVIDE LEGAL DIMENSIONS OR LOCATIONS OF PROPERTY OWNERSHIP LINES.


# T. 12 S., R. 9 E., W.M.

024 13 1990

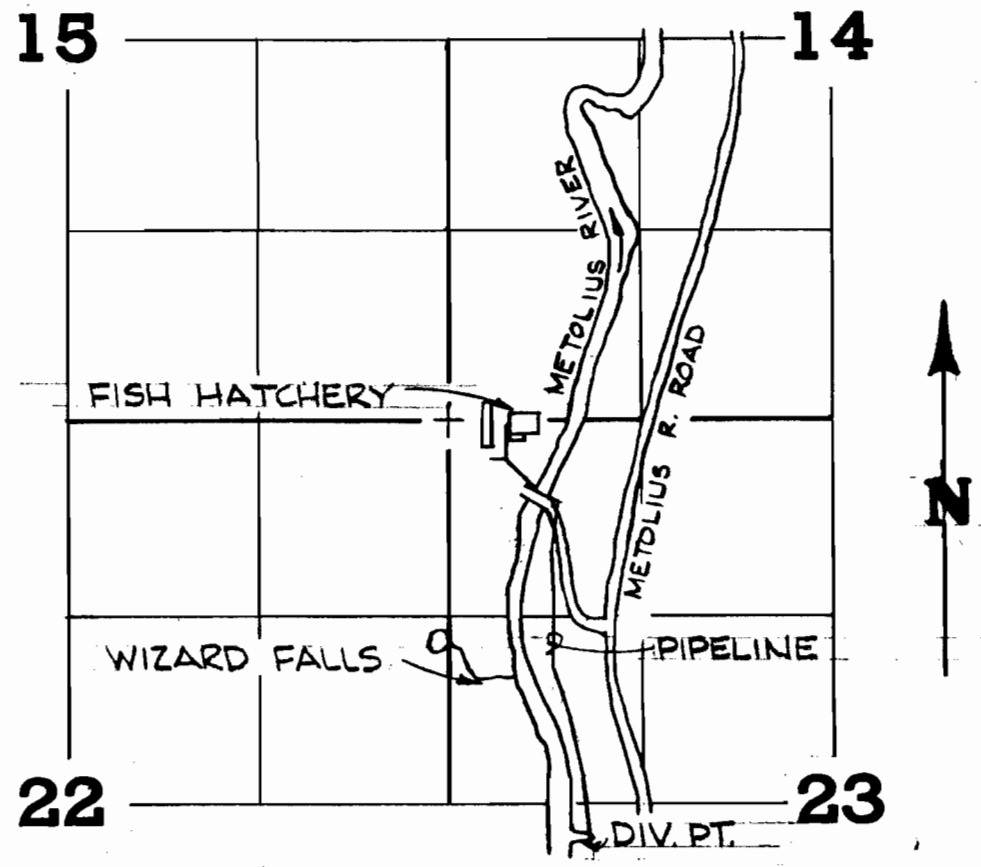

DIV. PT. LOCATED 2699.18' S. & 994.59' E. FROM NW COR. SEC. 23.

SCALE : 4" = 1 MILE

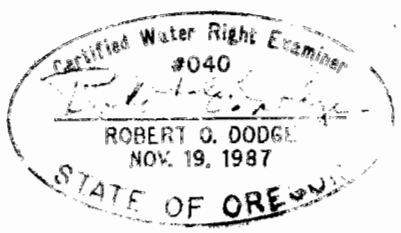

## FINAL PROOF SURVEY UNDER

Application No. 70195 Permit No. 50954  
IN NAME OF

OREGON DEPARTMENT OF FISH AND WILDLIFE

Surveyed SEPT 20, 1990, by DODGE