



T. 19 S., R. 6 W., WM
SECTION 2

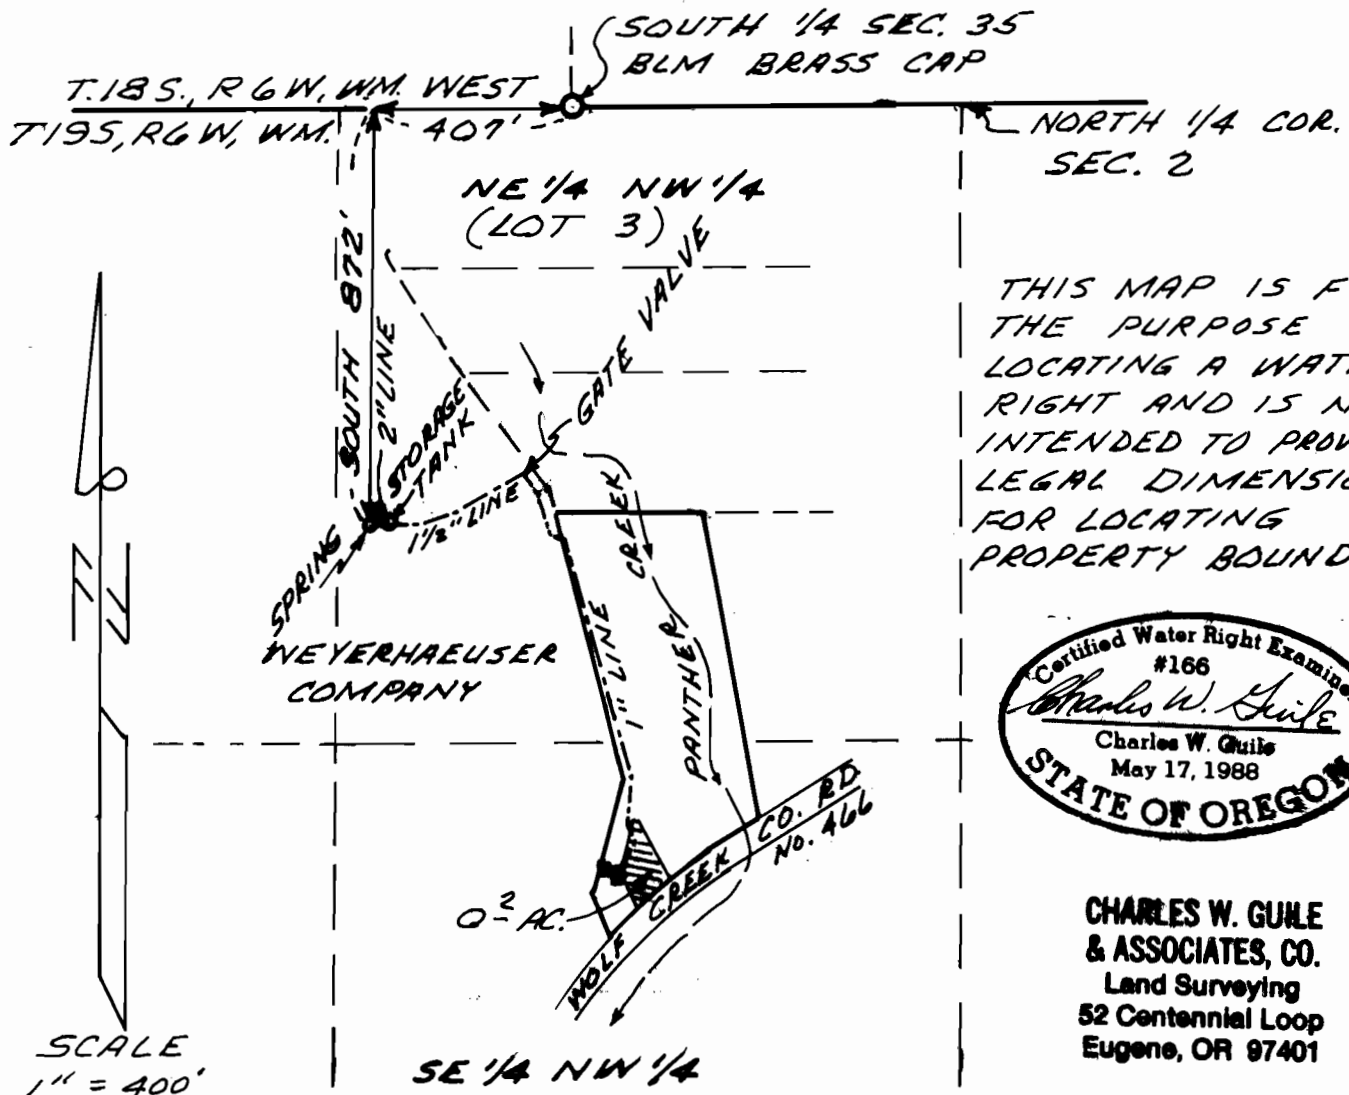

THIS MAP IS FOR
THE PURPOSE OF
LOCATING A WATER
RIGHT AND IS NOT
INTENDED TO PROVIDE
LEGAL DIMENSIONS
FOR LOCATING
PROPERTY BOUNDS.

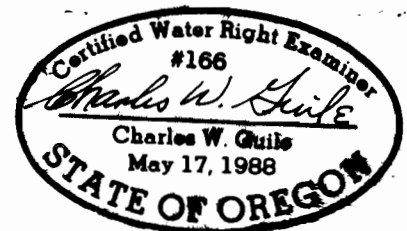

CHARLES W. GUILÉ
& ASSOCIATES, CO.
Land Surveying
52 Centennial Loop
Eugene, OR 97401

FINAL PROOF SURVEY

UNDER
APPLICATION NO. 69910 PERMIT NO. 51118

IN NAME OF

HERMAN J. DAILY

SURVEY APRIL 3, 1991 BY Charles W. Guile

8956