
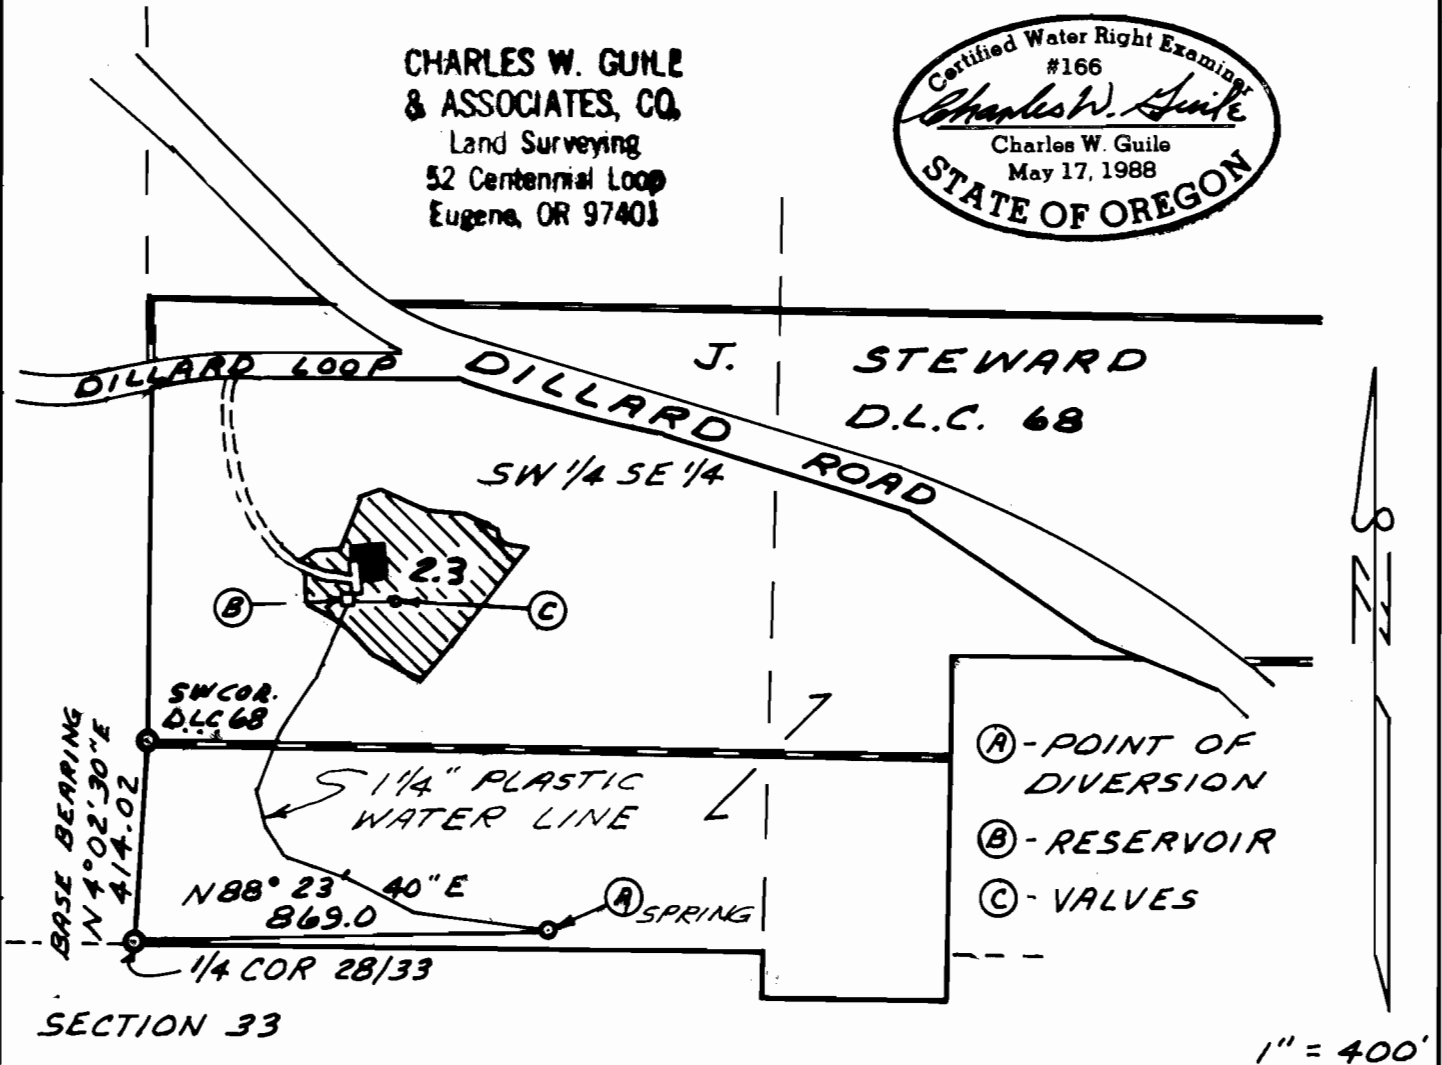


T.18 S., R.3 W., W.M.
SECTION 28

CHARLES W. GUILLE
& ASSOCIATES, CO.
Land Surveying
52 Centennial Loop
Eugene, OR 97401

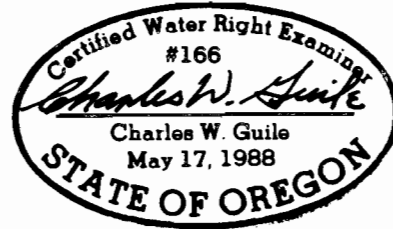

FINAL PROOF SURVEY
UNDER

APPLICATION NO. _____ PERMIT NO. 50871

IN NAME OF

PATRICIA ALEXANDER

SURVEYED. JAN. 8, 1991 BY Charles W. Guile