

T 26 S R 7 W W M
SECTION 3
FINAL PROOF SURVEY

UNDER

APPLICATION NO. 70052


PERMIT NO. 50839

IN THE NAME OF

ARCHIE L. & BEVERLY D. CLARNO



SCALE 1" = 400'
APRIL 3, 1990

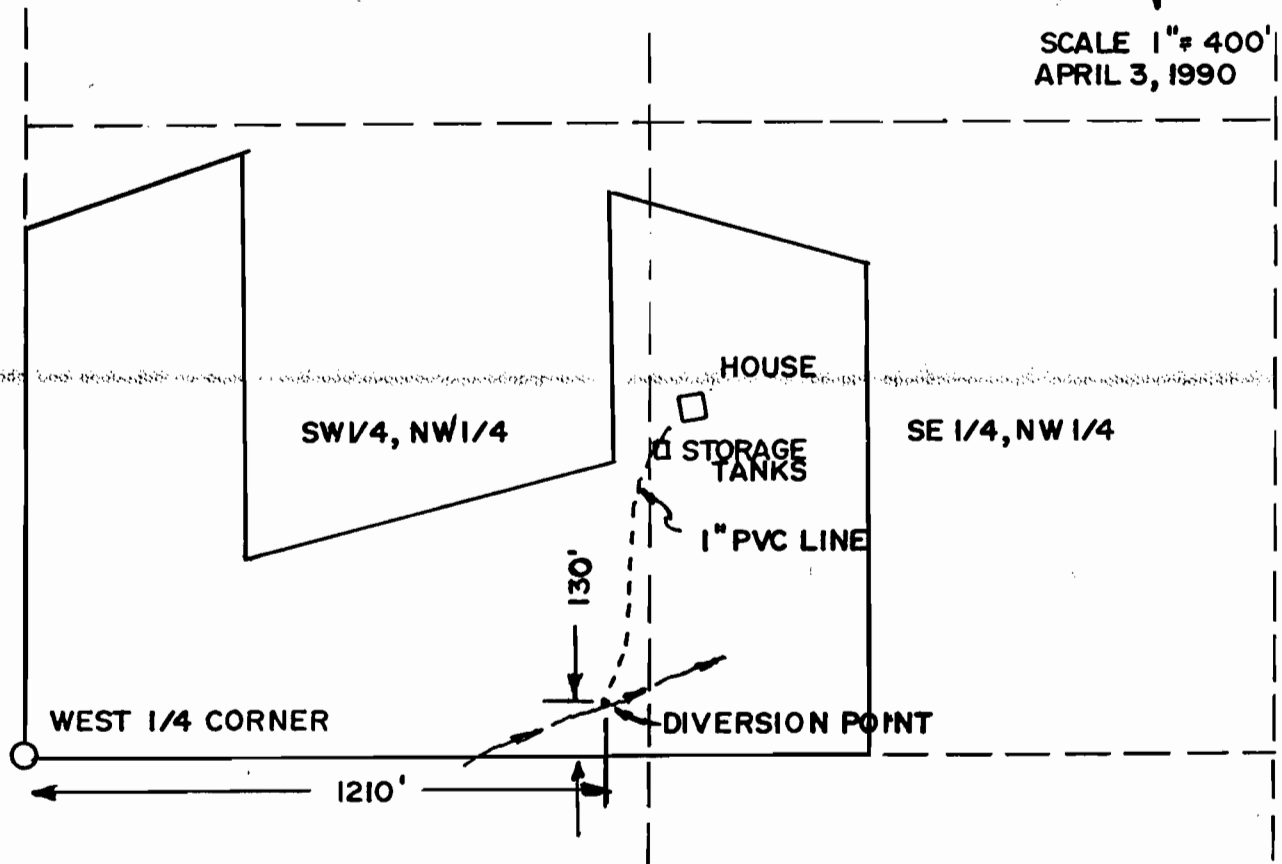

CWRE JAMES D. ARTMAN
PO BOX 576
WINSTON, OREGON 97496
(503) 679-7176

